

GOVERNMENT CORNER RESTORATION FORM

Date: 9-23-97 By: PC

Township 28S Range 8W Sec. 34 County DOUGLAS This survey consists of:

State OR Date 9-17-97 No. _____

Corner Designation

Corner No: CS 04/78-3

1/4 534 / 53

- Condition as Found
- Not Found
- Renewed
- Unrecorded
- Surveyed In
- Referenced Out

Previous Renewals 1969 DCSO

Monument(s) Found: (Condition and Source)

2 1/2" BRASS CAP ON A 1 1/2" O.D. IRON PIPE PROTRUDING 11" ABOVE GROUND (1969)

COUNTY SURVEYORS OFFICE T285

1/4 534 / 53 R 8 W

T285 1969

Accessories Found:

1 1/4" NOW 23" DIA. D.FIR WITH A FULLY HEALED DOUBLE BLAZE BEARS N 66 3/4° E, 89.2 FT AGREES WITH BT TAG BY SHANER 1/72 (REC PER 1969 DCSO N 72° E, 89.2 FT) 1969

1 1/2" NOW 23" DIA. D.FIR WITH A FULLY HEALED DOUBLE BLAZE BEARS S 64° E, 69.1 FT (REC S 64° E, 65.1 FT) 1969

10" B.OAK NO BLAZES VISIBLE WITH A 1972 SHANER LINE TAG BEARS S 73° E, 52 FT AGREES WITH TAG W/6 DOUBLE BLAZE AND SCRIBE "1/4 S 3 CS BT"

Monument Set (Procedure and Description)

Monument Detail

NONE


N/A

New Accessories

13" DIA. D.FIR DOUBLE BLAZED AND SCRIBED "Y4S39
CS BT BEARS N26°W 20.8 FT

Sketch of Monument, Accessories, and General Area

Location & Comments

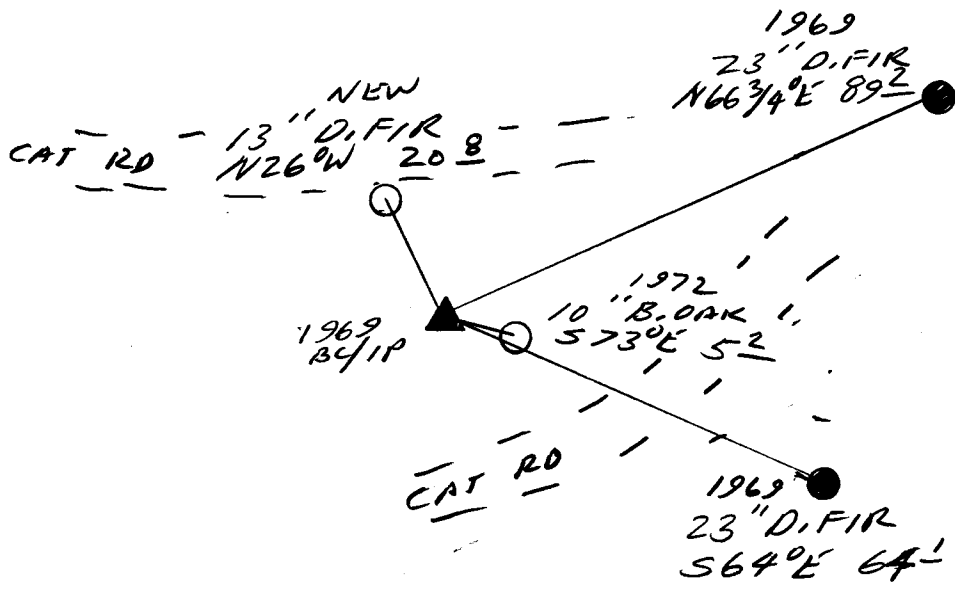

Comp. Declin. 173/4°E
 Agency DCSO
 Party Chief RANDALL W. SMITH
 Notekeeper [Signature]
 Witnesses STEPHEN J. FLAISE

Address

Surveyor's Seal
 REGISTERED
 PROFESSIONAL
 LAND SURVEYOR
 [Signature]
 OREGON
 JULY 25, 1990
 RANDALL W. SMITH
 2469