

GOVERNMENT CORNER RESTORATION FORM

Date: 9-24-97 By: JP

This survey consists of:

Township R55 Range 3W Sec. 35 County DOUGLAS Map: _____

State OR Date 9-23-97 No. _____

Narrative: _____

Corner Rpt: C.S. 64/78-5

Corner Designation

DOUGLAS COUNTY SURVEYOR

Condition Report Only

Not Found

Renewed

Unrecorded

Surveyed In

Referenced Out

$\frac{1}{4} \frac{S35}{S2}$

Previous Renewals 1940 GLO, 1965 WEYERHAEUSER

MONUMENT DETAIL

Monument(s) Found: (Condition and Source)

1966 DCSO

NO MONUMENT FOUND. CORNER FALLS ON THE NORTHERLY EDGE OF AN OLD CAT ROAD.

N/A

Accessories Found:

50" NOW 50" DIA 2 FT HIGH D. FIR STUMP WITH SCRIBING VISIBLE "BT" AND W. NAIL. W. NAIL BEARS S 51° W, 34.0 FT TO W. NAIL. (35.6 FT TO CENTER) (AGREES WITH REC.) 1940

1940 NE BT NOW GONE
1965 NE BT NOW GONE

38" NOW ROOTED AND BURNT 45 FT HIGH CEDAR SNAG BEARS A 98° W, 49.0 FT TO CENTER. W NAIL NOT FOUND (REC TO W NAIL, N 52° W, 42.0 FT) 1965

6" NOW 17" DIA HEMLOCK WITH A FULLY HEALED DOUBLE BLAZE, BEARS S 25° W, 68.2 FT (AGREES WITH REC.) 1966

RENEWAL

Monument Set (Procedure and Description)

AT A POSITION DETERMINED FROM REMAINING RT'S AS SHOWN ON FRONT A 7 3/8" BRASS CAP ON A 1 7/8" BY 3/4" LONG IRON PIPE IS SET, PROTRUDES 8" ABOVE GROUND.


Monument Detail

DOUGLAS COUNTY SURVEYORS
 T 255
 1/4 S 35 R
 52 3 W
 T 265
 1997
 OFFICE

New Accessories

- 12" DIA. D. FIR DOUBLE BLAZED AND SCRIBED "1/4 S 35 CS BT" BEARS N 45 1/2° E 22.1 FT
- 13" DIA. D. FIR DOUBLE BLAZED AND SCRIBED "1/4 S 2 CS BT" BEARS S 33 1/2° E 24.1 FT
- 7" DIA. D. FIR DOUBLE BLAZED AND SCRIBED "1/4 S 2 CS BT" BEARS S 87 1/2° W 20.0 FT
- 7" DIA. D. FIR DOUBLE BLAZED AND SCRIBED "1/4 S 35 CS BT" BEARS N 56° W 20.7 FT

Sketch of Monument, Accessories, and General Area

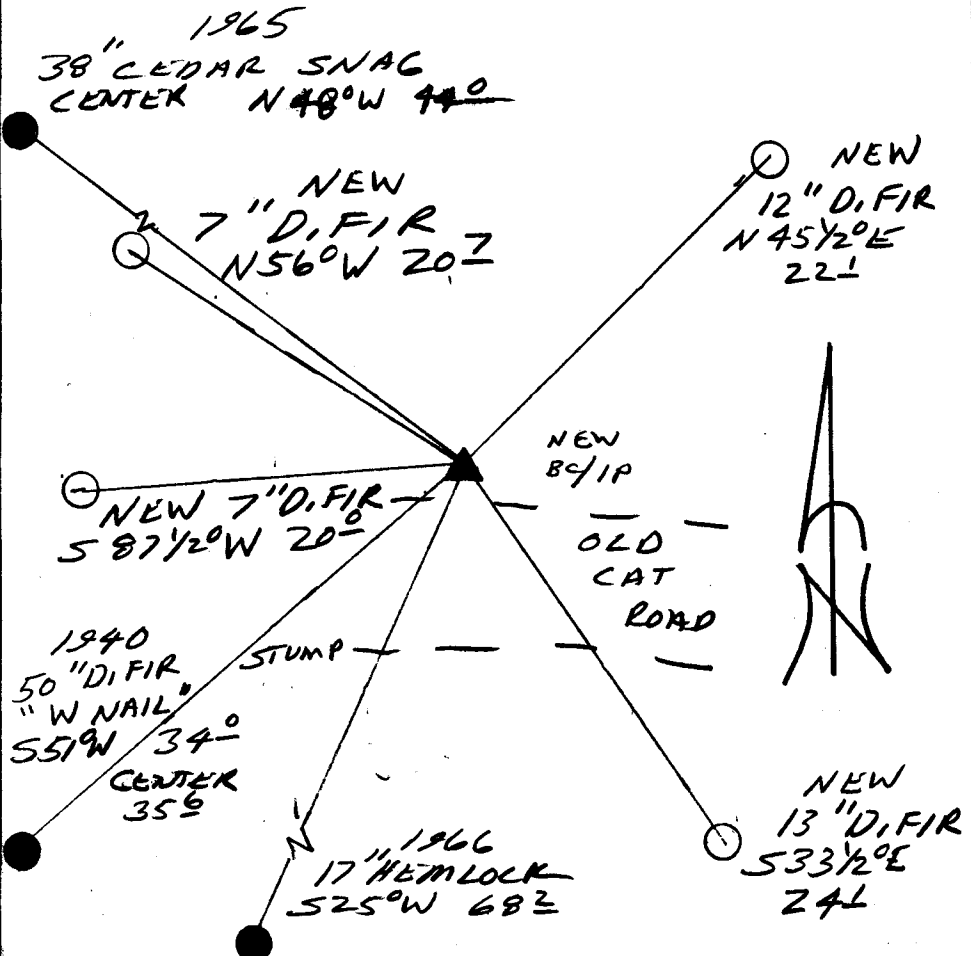

Location & Comments

CORNER LIES ON NORTHERLY EDGE OF AN OLD CAT ROAD

Comp. Declin. 17 3/4° E
 Agency DCSO
 Party Chief RANDALL W. SMITH
 Notekeeper [Signature]
 Witnesses STEVEN J. FLASK

Address _____

Surveyor's Seal

REGISTERED
 PROFESSIONAL
 LAND SURVEYOR

Randall W. Smith
 EXPIRES 6-30-98

OREGON
 JULY 25, 1990
 RANDALL W. SMITH
 2489