

GOVERNMENT CORNER RESTORATION FORM

Date: 9-29-97 By: AC

Township 25S Range 2W Sec. 6

County DOUGLAS This survey consists of:

State OR Date 9-25-97 No. _____

Map: _____

Narrative: _____

Corner Designation _____

Corner Rpt: CS 04/78-7

56 CC
57

- DOUGLAS COUNTY SURVEYOR
- Condition Only
 - Not Found
 - Renewed
 - Unrecorded
 - Surveyed In
 - Referenced Out

MONUMENT DETAIL

Previous Renewals 1940 GLO, 1966 DC SO

Monument(s) Found: (Condition and Source)

2 1/2" BRASS CAP ON A
2" DIA. IRON PIPE PROTRUDES
12" ABOVE GROUND.

U.S. GENERAL LAND

T 25S		T 25S	
R 3W		56	C
S 12		57	C
700573		R 2W	100600
		1943	

OFFICE SURVEY

Accessories Found:

30" NOW 34" DIA, 6 FT HIGH D.FIR STUMP
WITH ILLEGIBLE SCRIBING ON A
PARTIALLY HEALED SINGLE BLAZE.
BEARS N 50 3/4° E, 15.2 FT (AGREES WITH
REC.) 1940 GLO

32" NOW 36" DIA, 5 FT HIGH D.FIR STUMP
WITH SCRIBING "T 25S R 2" VISIBLE ON
A PARTIALLY HEALED SINGLE BLAZE.
BEARS S 20 1/2° E, 13.9 FT (AGREES WITH
REC.) 1940 GLO

(AREA AROUND CORNER IS OVER GROWN
WITH BRUSH BRG'S AND DIST'S TO 1966)
DC SO BT'S NOT CHECKED.

8" NOW 10" DIA YEW WITH A PARTIALLY HEALED
DOUBLE BLAZE, SCRIBING VISIBLE " 25S R 2W
57 CC CS BT", (REC. S 63° E, 168.2 FT) 1966

12" NOW 26" DIA, HEMLOCK WITH ILLEGIBLE SCRIBING
VISIBLE ON A PARTIALLY HEALED DOUBLE BLAZE,
(REC. N 7° E, 22.3 FT) 1966

Monument Set (Procedure and Description)

Monument Detail

NONE


N/A

New Accessories

10" DIA. D. FIR DOUBLE BLAZED AND SCRIBED
"T255 R2W S6 CC CS RT" BEARS N66 1/2° E, 6.4 FT

7" DIA. D. FIR DOUBLE BLAZED AND SCRIBED
"T255 R2W S7 CC CS RT" BEARS S12 1/2° E, 36.3 FT

Sketch of Monument, Accessories, and General Area

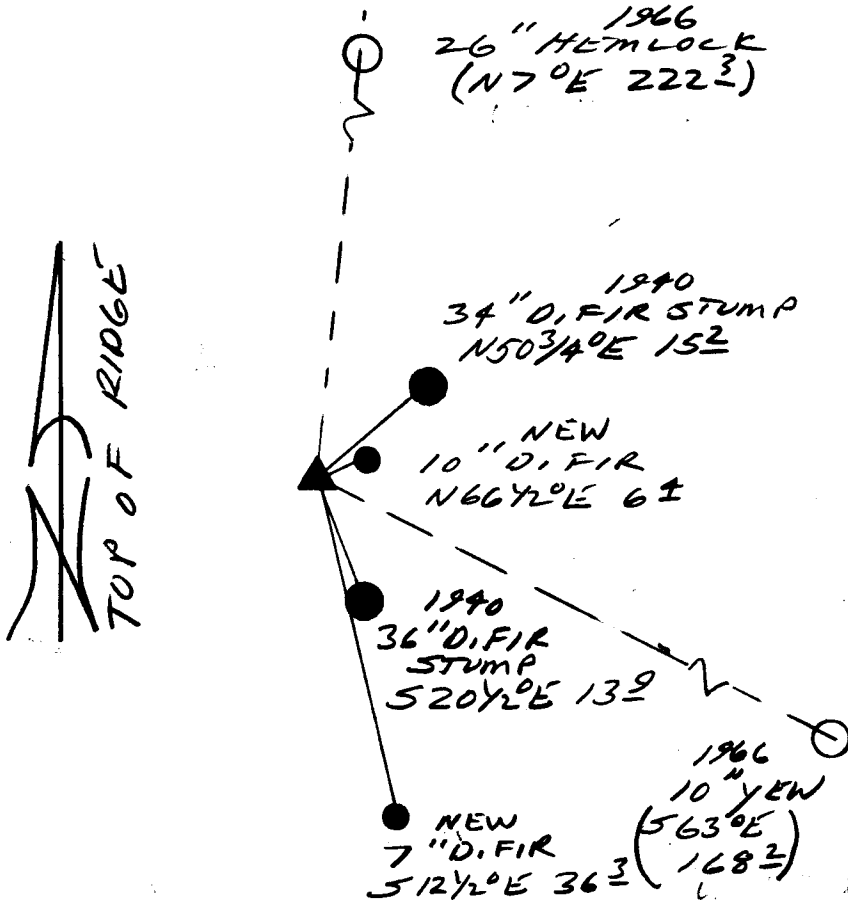

Location & Comments

Comp. Declin. 173/4° E
 Agency DCSO
 Party Chief RANDALL W. SMITH
 Notekeeper [Signature]
 Witnesses STEPHEN J. FRAUSE

Address

Surveyor's Seal

REGISTERED
 PROFESSIONAL
 LAND SURVEYOR

[Signature]
 EXPIRES 6-30-99

OREGON
 JULY 25, 1980
 RANDALL W. SMITH
 2409