

GOVERNMENT CORNER RESTORATION FORM

Date: 10-9-97 By: BC

This survey consists of:

Township 30S Range 3W Sec. 16 County DOUGLAS Map: \_\_\_\_\_

State OR Date 9-29-97 No. \_\_\_\_\_ Narrative: \_\_\_\_\_

Corner Rpt: CS 64/78-8

Corner Designation

S17/S16  
S20/S21

DOUGLAS COUNTY  
SURVEYOR

Condition Report Only

Not Found

Renewed

Unrecorded

Surveyed In

Referenced Out

MONUMENT DETAIL

Previous Renewals 1952 MARKHAM, 1963 DCSO, 1972 BLM

Monument(s) Found: (Condition and Source)

3 1/2" BRASS CAP ON A 2 1/2" O.D. IRON PIPE PROTRUDING 8" ABOVE GROUND. (1972)

1" I.D. IRON PIPE IS ALONG SW 1/4 EDGE OF BC/IR. PROTRUDING 7" ABOVE GROUND (1952)

U.S. DEPT OF THE INTERIOR  
T30S R3W

S17/S16  
S20/S21

1972

BUR. OF LAND MANAGEMENT

Accessories Found:

32" NOW BURNED AND ROTTED D.F. FIR STUMP NO BLAZES OR SCRIBING VISIBLE, BEARS S23/20E, 35.0 FT (AGREES WITH REC.) 1972

36" NOW 42" DIA. 5 FT HIGH D.F. FIR STUMP WITH A HEALED BLAZE, BEARS N66°W, 111.0 FT (AGREES WITH 1952 & 1963 REC.) 1952

23" NOW 32" DIA. 1 1/2 FT HIGH MADRONE STUMP NO BLAZE VISIBLE, BEARS N67/4°E, 54.5 FT TO CENTER (REC N66°E 53.0 FT) 1952

12" NOW 20" DIA MAPLE, NO BLAZE VISIBLE, BEARS S51°W, 44.4 FT. (REC. S49°W, 42.9 FT) 1952

26" NOW 42" DIA. 2 FT HIGH CEDAR STUMP WITH A FULLY HEALED SINGLE BLAZE, BEARS S79°E, 90.4 FT (AGREES WITH 1972 REC.) 1963

7" NOW 12" DIA. 2 FT HIGH D.F. FIR STUMP WITH A FULLY HEALED BLAZE, BEARS N54°E, 46.9 FT (AGREES WITH REC.) 1972

7" NOW 9" DIA. 70' HIGH D.F. FIR SNAG WITH A ROTTED BURNED BLAZE, NO SCRIBING VISIBLE, BEARS S85°W, 84.5 FT (AGREES WITH REC.) 1972

Monument Set (Procedure and Description)

Monument Detail

NONE


N/A

New Accessories

5/8" x 30" LONG I.R. WITH A DCSO ALUM. CAP. STAMPED "B02"  
1997" PROTRUDES 8" ABOVE GROUND, BEARS WEST, 571.7 FT.

5/8" x 30" LONG I.R. WITH A DCSO ALUM. CAP. STAMPED "B01"  
1997" PROTRUDES 8" ABOVE GROUND, BEARS NORTH, 98.3 FT

Sketch of Monument, Accessories, and General Area

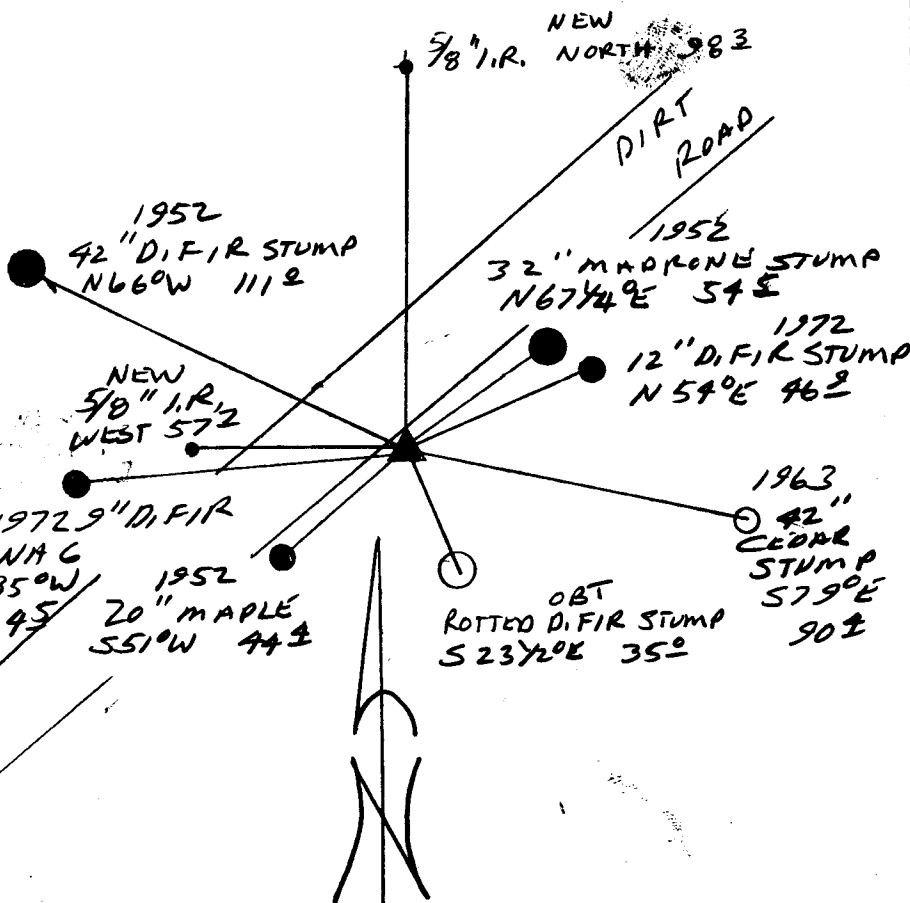

Location & Comments

CORNER LIES 25 FT EAST OF A RIDGE TOP ROAD. AREA BURNT AND LOGGED AROUND CORNER

Comp. Declin. 173/40E  
Agency DCSO  
Party Chief RANDALL W. SMITH  
Notekeeper  
Witnesses STEPHEN J. FLAISE

Address

Surveyor's Seal

REGISTERED PROFESSIONAL LAND SURVEYOR

*Randall W. Smith*  
EXPIRES 6-30-96

OREGON  
JULY 25, 1990  
RANDALL W. SMITH  
2409