

GOVERNMENT CORNER RESTORATION FORM

Date: 10-13-97 By: PCG

This survey consists of:

Township 24S Range 5W Sec. 34

County DOUGLASS Map:

State OK

Date 10-2-97

No.

Narrative:

Corner Rpt: 6478-9

Corner Designation

T 24S

S34	S35	R
S3	S2	S
		W

T 25S

DOUGLASS COUNTY SURVEYOR

Condition Report Only

Not Found

Renewed

Unrecorded

Surveyed In

Referenced Out

MONUMENT DETAIL

Previous Renewals 1933, 1954, 1957, 1963, 1980

Monument(s) Found: (Condition and Source)

NO MONUMENT FOUND
CORNER NOW FALLS INSIDE
METAL SHED WITH CONCRETE
FLOOR.

N/A

Accessories Found:

FROM CALC. CORNER POSITION
12" NOW 24" DIA 2 1/2 FT HIGH ROTTED ASH
STUMP, NO SCRIBING VISIBLE BEARS S 1/2° E 32.3 FT
(AGREES WITH 1980 DCSO CORNER REN SEE CS 61/11-22)
1933 BT

9" NOW 15" DIA W. OAK WITH A FULLY HEALED
DOUBLE BLAZE BEARS S 60° E 145.8 FT (REC.
S 60° E, 146.5' DIST. FITS WELL AS A SLOPE
MEASUREMENT) 1963 BT

10" NOW 38" DIA 10 FT HIGH ROTTED OAK SNAG
NO SCRIBING VISIBLE BEARS S 65° E 316.7 FT
(REC. S 65° E, 318.8 FT DIST. FITS WELL AS A
SLOPE MEASUREMENT) OBT

NO OTHER BT'S FOUND

RENEWAL

Monument Detail

Monument Set (Procedure and Description)

2 7/8" DIA. BRASS CAP ON A 1 3/8" O.D. BY 32" LONG IRON PIPE IS SET AS BEARING OBJECT TO CALCULATED POSITION OF CORNER DETERMINED FROM FOUND B.T.'S, PROTRUDES 5" ABOVE GROUND.

DOUGLAS COUNTY SURVEYORS

BO 1
CORNER
BEARS
N 54 1/4° E 125.7 FT

1997

New Accessories BRG'S + DISTANCE TAKEN FROM BC/IP "BO 1"
10" W. OAK DOUBLE BLAZED AND SCRIBED "BO 1 CS BT"
BEARS S 11 1/2° E, 50.0 FT
DOUBLE TRUNKED HAWTHORN DOUBLE BLAZED AND SCRIBED "BO 1 CS BT"
ON 9" SE TRUNK, CENTER OF ROOT CROWN BEARS N 27 1/2° W, 67.9 FT
15" W. OAK 1963 BT BEARS N 89 1/2° E, 228.6 FT

Sketch of Monument, Accessories, and General Area

ATTACHED

Location & Comments

BO 1 BC/IP IS
12 FT EAST OF
GRAVEL ROAD

Comp. Declin. 17 3/4° E
Agency DESO
Party Chief RANDALL W. SMITH
Notekeeper [Signature]
Witnesses STEPHEN J. FLAISE

Address

Surveyor's Seal

REGISTERED
PROFESSIONAL
LAND SURVEYOR

[Signature]
EXPIRES 6-30-98

OREGON
JULY 25, 1990
RANDALL W. SMITH
2469

Job ID : BRN
 Job name : T 22 & 25 S R 5 W S34 S35 S3 S2
 Description :
 Reference :
 Projection : None
 Date printed: 13/10/97 7:40am

Radial report from point 2001 (COORD)

Point	Azimuth	Distance	Northing	Easting	Elevation	Name
2001	-	-	1095.188	1011.995	495.104	COORD
4	S65°25'28"E	316.720	963.466	1300.024	544.000	PEG <i>OBT</i>
3	S60°29'13"E	145.622	1023.451	1138.721	507.945	PEG <i>OAK 1963</i>
2	S1°30'00"E	37.300	1057.900	1012.971	495.104	PEG <i>ASH 1933</i>
1	S54°09'32"W	125.710	1021.579	910.089	495.241	CP <i>BO 1</i>

BEARINGS ARE CLOSE TO RECORD

NEW
9" HAWTHORN
N 27 1/2° W 67.2

SET
B01

1997 BC/1P

GRAVEL RD

NEW
10" W. OAK
S 11 1/2° E 50.2

N 89 1/2° E 228.6

N 54 1/4° E
S 1 1/2° E
24 3/4" ASH STUMP


1933
S 1 1/2° E

SHED

BARN

CALC. CORNER
POSITION

1963
15" W. OAK
S 60° E 145.2

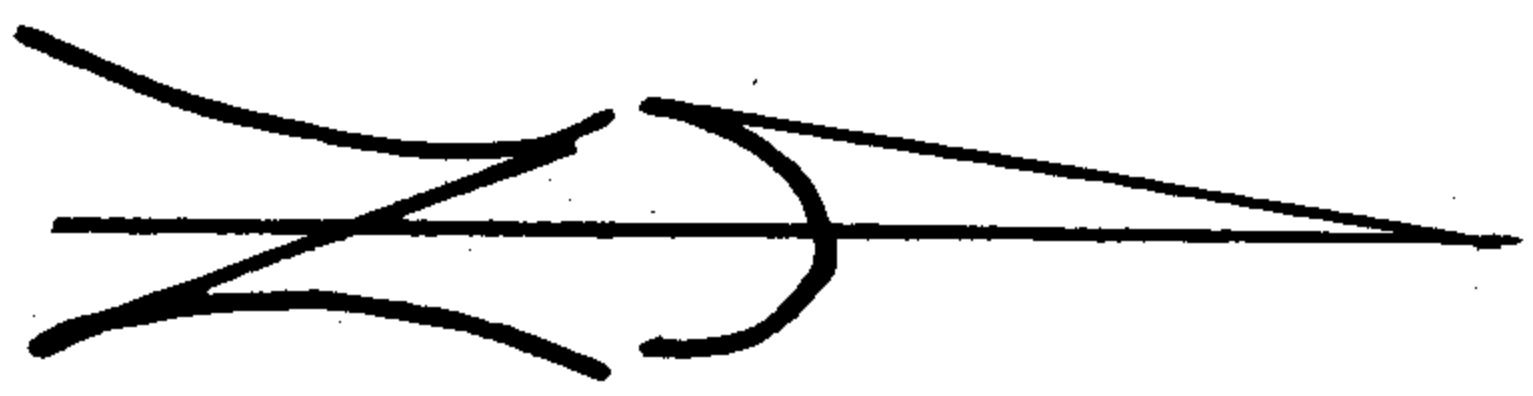

38" OBT
W. OAK SNAG
S 65° E 36.2

REGISTERED
PROFESSIONAL
LAND SURVEYOR
ORIGON
JULY 25, 1990
RANDALL W. SMITH
2489

Handwritten signature and date:
Randall W. Smith
7/25/90