

GOVERNMENT CORNER RESTORATION FORM

Date: 10/30/97 By: JP

This survey consists of:

Township 265 Range SW Sec. 14 County DOUGLAS

Map: _____

State OK Date 10-28-97 No. _____

Narrative: _____

Corner Rpt: CS 64/70-16

Corner Designation

DOUGLAS COUNTY SURVEYOR

S15 | S14

S22 | S23

- Condition Report Only
- Not Found
- Renewed
- Unrecorded
- Surveyed In
- Referenced Out

MONUMENT DETAIL

Previous Renewals 1958 DCB

Monument(s) Found: (Condition and Source)

2 1/2" DIA BRASS CAP ON A 1 1/2" OLD IRON PIPE PROTRUDING 15" ABOVE GROUND. 1958

COUNTY SURVEYORS OFFICE

T265 R5W

S15 | S14

S22 | S23

1958

Accessories Found:

ORIG. BRG'S IN 1958 RENEWAL NOTED AS HAVING A 2° ROTATION

14" NOW 33" DIA. W. OAK WITH A PREVIOUSLY OPENED PARTIALLY HEALED BLAZE, NO SCRIBING VISIBLE, BEARS N 80 1/2° E, 440.4 FT (ORIG. REC. N 78 1/2° E, 442.2 FT DIST. FITS WELL FOR A SLOPE MEASUREMENT). OBT

15" NOW 40" DOWN AND ROTTED OAK OLD BLAZE AND ILLEGIBLE, SCRIBING FOUND (ORIG. REC. N 83 1/2° W, 280.5 FT). OBT

11" NOW 28" DIA. W. OAK WITH A PREVIOUSLY OPENED PARTIALLY HEALED BLAZE, NO SCRIBING VISIBLE, BEARS S 46 3/4° E, 311.5 FT (ORIG. REC. S 49 3/4° E, 311.5 FT). OBT

13" NOW 19" DIA. W. OAK WITH A FULLY HEALED DOUBLE BLAZE, BEARS S 77° E, 166.9 FT (REC. S 77° E 167.0 FT) 1958

12" NOW 17" DIA. W. OAK WITH A FULLY HEALED DOUBLE BLAZE, BEARS N 77° E, 372.9 FT (REC. N 77° E 373.4 FT) 1958

20" NOW 25" DIA. W. OAK WITH A FULLY HEALED DOUBLE BLAZE, BEARS N 80° W 158.3 FT (AGREES WITH REC.) 1958

C.S. File No. 64/70-16

Monument Set (Procedure and Description)

Monument Detail

SURROUND WITH A MOUND OF STONE


N/A

New Accessories

NONE

Sketch of Monument, Accessories, and General Area

Location & Comments

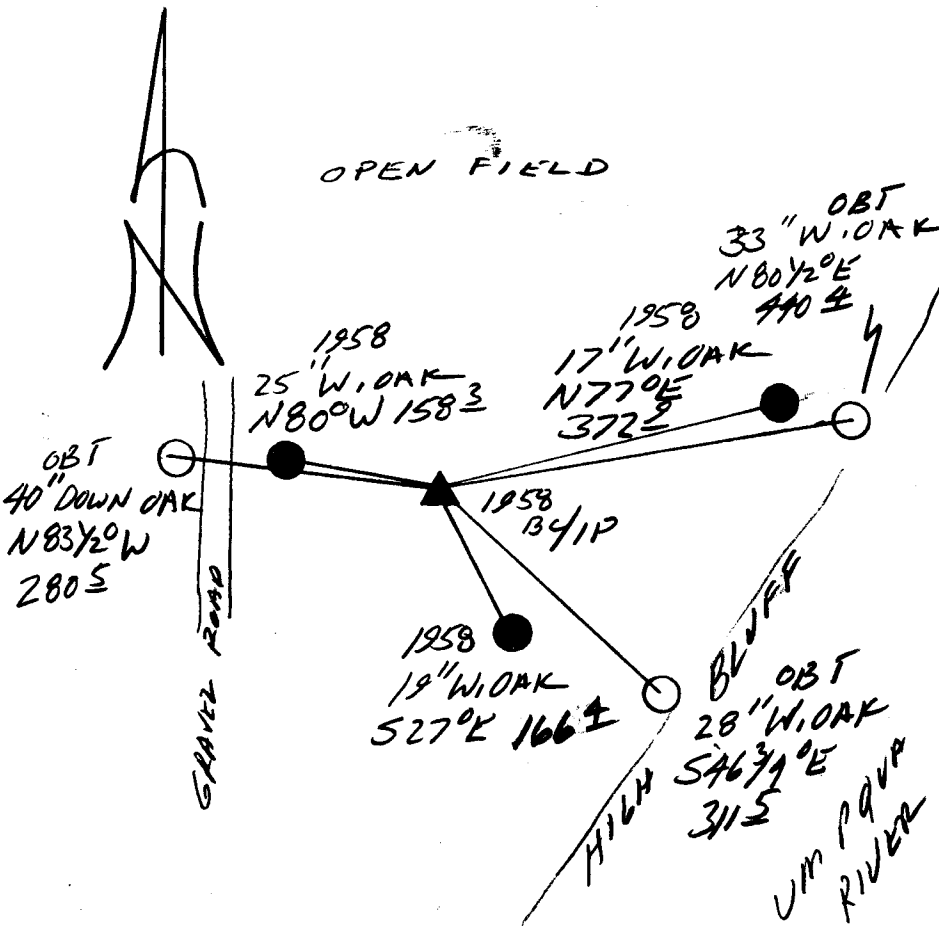

Comp. Declin. 17 3/4° E
 Agency DCSO
 Party Chief RANDALL W. SMITH
 Notekeeper [Signature]
 Witnesses STEPHEN J. FRANK

Address

Surveyor's Seal

REGISTERED
 PROFESSIONAL
 LAND SURVEYOR

Randall W. Smith
 Expires 6-30-98

OREGON
 JULY 25, 1990
 RANDALL W. SMITH
 2489