

Monument Set (Procedure and Description)

Monument Detail

N/A


N/A

New Accessories

GROWN TOGETHER 20" DBH. R. CEDAR DOUBLE BLAZED AND SCRIBED "Y458CS BT" ON SOUTHWEST TRUNK, ROOT CROWN BEARS N65°W 8.3 FT

6" DBH GRAND FIR DOUBLE BLAZED AND SCRIBED "Y459CS BT" BEARS S65°E, 12.3 FT

Sketch of Monument, Accessories, and General Area

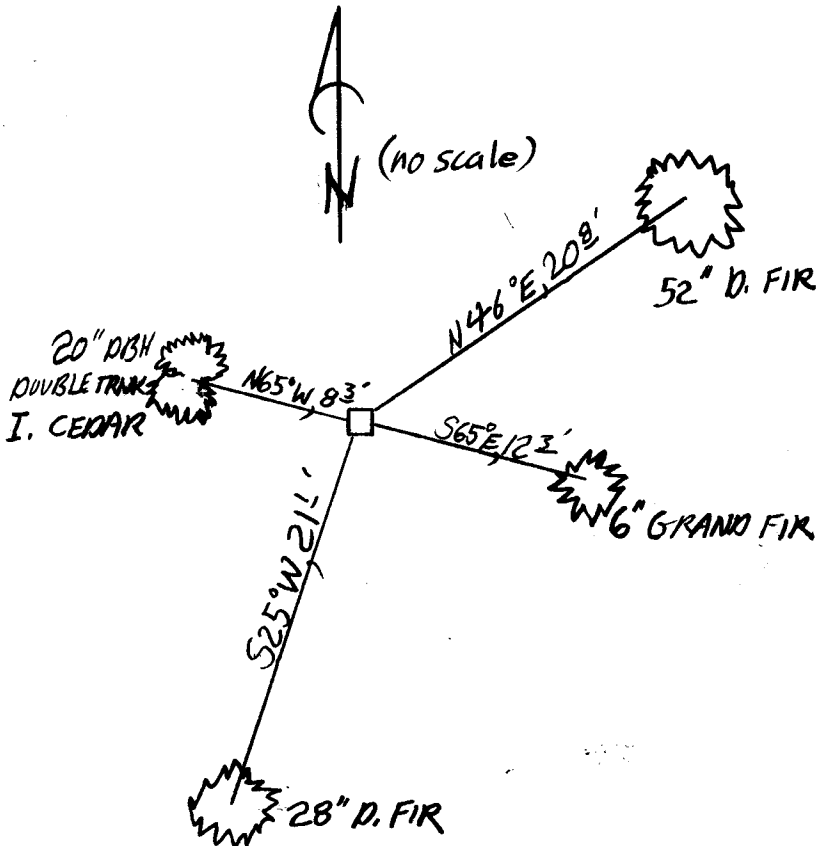

Location & Comments

CORNER IS APPROX. 200 FEET EAST FROM ABANDONED LOGGING SPIRIT ROAD. OLD GROWTH TREES STAND IN NORTHEAST QUADRANT CUTTING LINES RUN NORTH AND NORTH 45° EAST.

Comp. Declin. 17 1/2° E
Agency DCSO
Party Chief RANDALL W SMITH
Notekeeper [Signature]
Witnesses STEPHEN J FLAUS

Address

Surveyor's Seal

REGISTERED PROFESSIONAL LAND SURVEYOR

[Signature]
JULY 25 1990

OREGON
JULY 25, 1990
RANDALL W. SMITH
2469