

Monument Set (Procedure and Description)

Monument Detail

NONE


N/A

New Accessories

10" DIA. W. OAK DOUBLE BLAZED AND SCRIBED "Y4S15CS BT"
BEARS S45 1/2° W, 98.1 FT

6" DIA. MADRONE BARK SCRIBED "Y4S15CS BT"
BEARS S5 1/2° W, 15.9 FT

11" DIA W. OAK DOUBLE BLAZED AND SCRIBED "Y4S14CS BT"
BEARS N0 1/2° E, 102.4 FT
Sketch of Monument, Accessories, and General Area

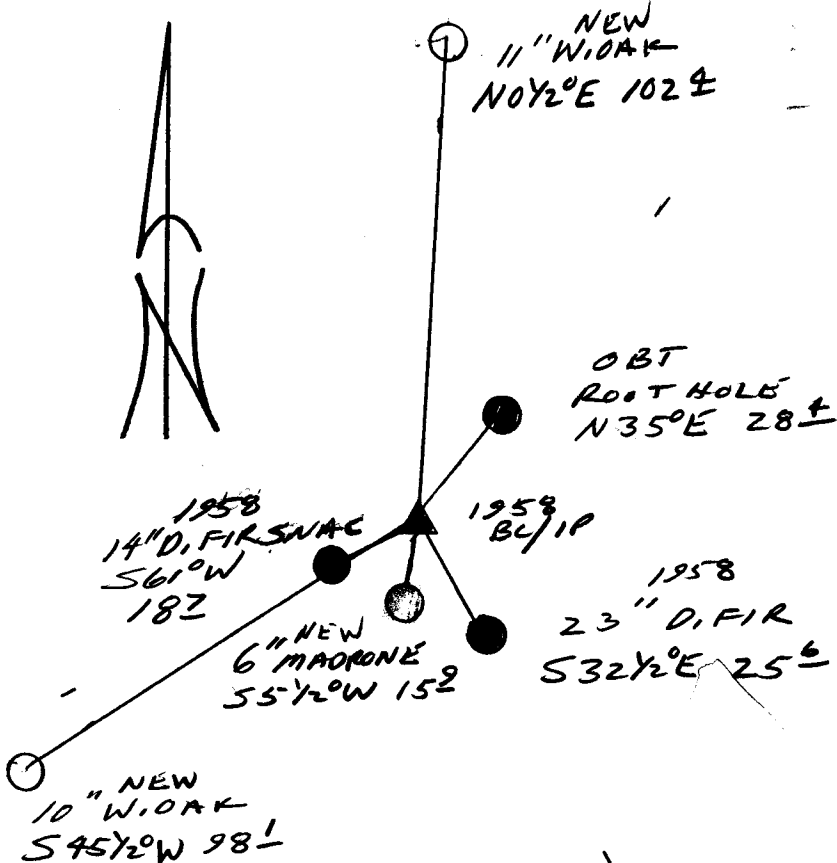

Location & Comments

Comp. Declin. 17 3/4° E
Agency PCSB
Party Chief RANDALL W. SMITH
Notekeeper [Signature]
Witnesses STEPHEN J. FLAUS

Address

Surveyor's Seal

REGISTERED
PROFESSIONAL
LAND SURVEYOR

[Signature]
JULY 25, 1990

OREGON
JULY 25, 1990
RANDALL W. SMITH
2469