

RENEWAL

Monument Detail

Monument Set (Procedure and Description)

1. P. DRIVEN DOWN, NOW PROTRUDES
4" ABOVE GROUND


N/A

New Accessories

12" DIA. MADRONE BARK SCRIBED "SW DCC 41 CS BT"
BEARS N 84° E, 23.5 FT

8" DIA MADRONE BARK SCRIBED "SW DCC 41 CS BT"
BEARS N 1/2° E, 21.1 FT

Sketch of Monument, Accessories, and General Area

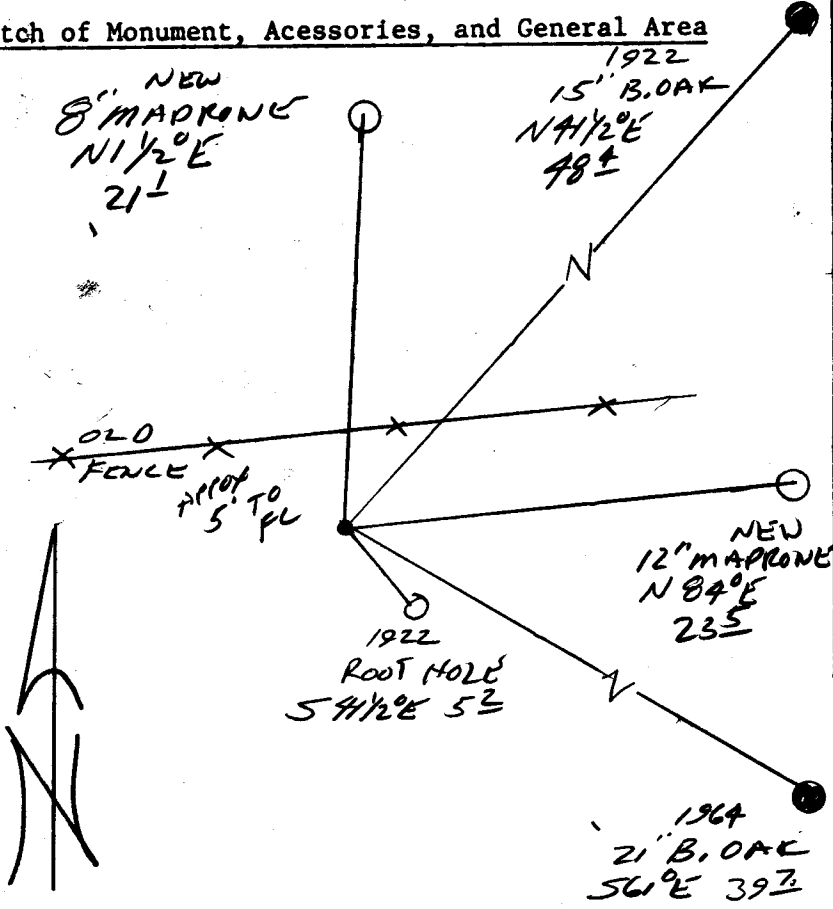

Location & Comments

Comp. Declin. 17 3/4° E
 Agency DLSO
 Party Chief RANDALL W SMITH
 Notekeeper [Signature]
 Witnesses STEPHEN J FLAISE

Address

Surveyor's Seal

REGISTERED
PROFESSIONAL
LAND SURVEYOR

Randall W Smith
EXPIRES 6-30-78

OREGON
JULY 25, 1960
RANDALL W. SMITH
2489