

RENEWAL

Monument Set (Procedure and Description)

Monument Detail


NONE

N/A

New Accessories

NONE

Sketch of Monument, Accessories, and General Area

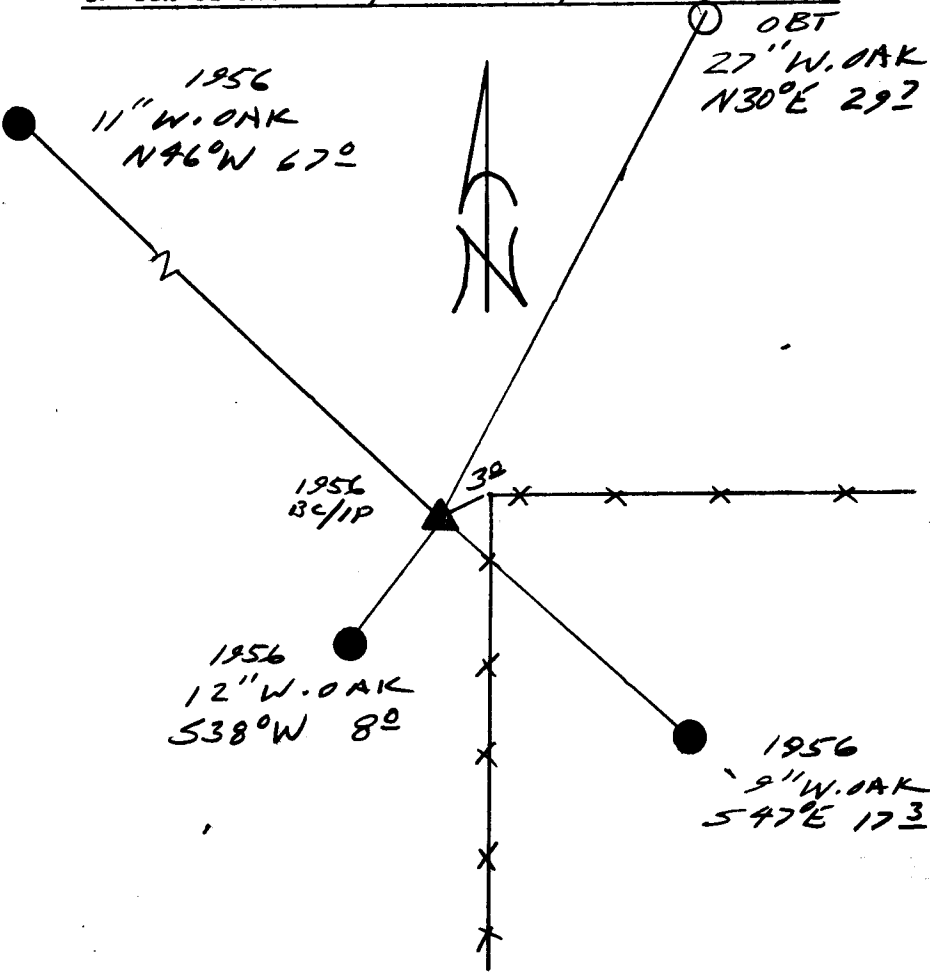

Location & Comments

FENCE CORNER RUNNING EAST + SOUTH BEARS N65°E 3 FT.

Comp. Declin. 17 3/4° E
 Agency DCSO
 Party Chief RANDALL W. SMITH
 Notekeeper [Signature]
 Witnesses STATION J. FLAUS

Address

Surveyor's Seal

REGISTERED
 PROFESSIONAL
 LAND SURVEYOR

Randall W. Smith
 EXPIRES 6-30-98

OREGON
 JULY 25, 1990
 RANDALL W. SMITH
 2469