

GOVERNMENT CORNER RESTORATION FORM

Township 29S Range 8W Sec. 20

County DOUGLAS

Date: 11/14/97 By: BC

This survey consists of:

State OK

Date 11-10-97

No. _____

Map: _____

Narrative: _____

Corner Designation

Corner Rpt: CS 64/78-26

S20	S21
S29	S28

DOUGLAS COUNTY
 Not For SURVEYOR
 Renewed
 Unrecorded
 Surveyed In
 Referenced Out

Previous Renewals 1923, 1958

Monument(s) Found: (Condition and Source)

2 1/2" DIA BRASS CAP ON A
1 1/2" O.D. IRON PIPE PROTRUDING
14" ABOVE GROUND. 1958

COUNTY SURVEYORS OFFICE
T29S R8W

S20	S21
S29	S28
1958	

Accessories Found:

6" NOW 24" DIA. D. FIR WITH A FULLY HEALED
DOUBLE BLAZE BEARS N20Y2°E / 34.3 FT
(REC. N22°E / 33.0 FT ORIG. AND N22°E
34.3 FT 1958) OBS

6" NOW 18" DIA. D. FIR WITH A FULLY HEALED
DOUBLE BLAZE BEARS S27°E 31.7 FT" OBS

25" NOW DOUBLE TRUNKED MAPLE MAIN TRUNK
IS 25" IN DIA. NORTHERLY TRUNK IS CUT AND
BLAZE IS ROTTED. W. BARK SCRIBE 14" SOUTHERLY
TRUNK "T29S R8W S20 CS BT" CENTER OF MAIN
TRUNK BEARS N83°W 29.6 FT (REC. N80Y2°W
29.6 FT) 1958

14" NOW 18" DIA DEAD CHINQUAPIN WITH A FULLY
HEALED DOUBLE BLAZE BEARS S69°W, 12.0 FT
(AGREES WITH REC.) 1958

30" NOW DOWN AND ROTTED NEAR REC. S66°E,
42.0 FT. 1923

26" NOW 28" DIA 3 FT HIGH D. FIR STUMP WITH A
FULLY HEALED SINGLE BLAZE, BEARS S49Y4°W 42.0 FT
(REC. S49Y4°W 41.0 FT) 1923

C.S. File No. 64/78-26

SEE BACK

Monument Set (Procedure and Description)

N/A


18" NOW 29" DIA. D.FIR WITH
A FULLY HEALED BLAZE BEARS
S 21° E, 14.8 FT (REL. S 18° E
14.8 FT) 1958

N/A

New Accessories

11" I. CEDAR DOUBLE BLAZED AND SCRUBED T29 S R8W
S 29° CS BT, BEARS S 96° W, 38.6 FT

Sketch of Monument, Accessories, and General Area

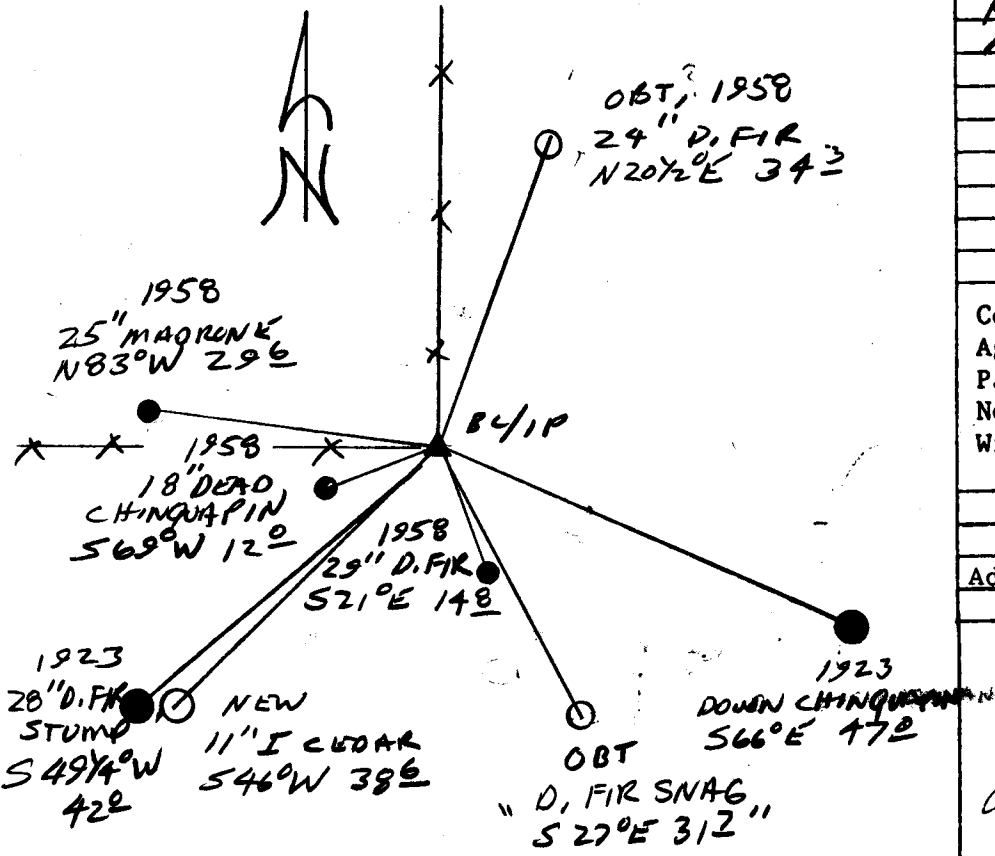

Location & Comments

FENCE CORNER BEARS
N 45° W 31.0 FT

Comp. Declin. 17 3/4° E
Agency DCSC
Party Chief RANDALL W. SMITH
Notekeeper
Witnesses STEPHEN J. FLAISE

Address

Surveyor's Seal

REGISTERED
PROFESSIONAL
LAND SURVEYOR

EXPIRES 6-30-98

OREGON
JULY 25, 1960
RANDALL W. SMITH
2469