

GOVERNMENT CORNER RESTORATION FORM

Date: 11/20/97 By: BC

Township 26 S Range 5 W Sec. 21 County DOUGLAS

This survey consists of:

State OK Date 11-12-97 No. \_\_\_\_\_

Map: \_\_\_\_\_

Narrative: \_\_\_\_\_

Corner Designation

WIT COR

Come: Rpt. CS 64/78-27

1/4 S 21 | S 22

DOUGLAS COUNTY

Condition SURVEYOR only

Not Found

Renewed

Unrecorded

Surveyed In

Referenced Out

Previous Renewals 1952 DCSG

Monument(s) Found: (Condition and Source)

NONE

N/A

Accessories Found:

8" NOW BROKEN ROTTEN OAK STAVES SHOWING EVIDENCE OF BEING OPENED NO SCRIBING FOUND, BEARS S 25° E, 75.6 FT (AGREES WITH REC.) OBT

6" NOW BROKEN ROTTEN OAK TIPPED OUT OF GROUND NO EVIDENCE OF BLAZES OR SCRIBING FOUND, BEARS S 18 1/2° W, 132.7 FT (AGREES WITH REC.) OBT

18" NOW 3 1/2" DIA. D. FIR WITH A FULLY HEALED SINGLE BLAZE, BEARS S 34 1/2° E, 53.1 FT (AGREES WITH REC.) 1952

8" NOW 1 1/4" DIA. B. OAK WITH A FULLY HEALED SINGLE BLAZE, BEARS S 45° W, 62.0 FT (REC. S 45° W, 58.9 FT) 1952

Monument Set (Procedure and Description)

SET A 8" NAIL IN ROCK BLUFF, SET FLUSH.

NOTE: UNABLE TO SET STANDARD SURVEY MONUMENT AS CORNER FALLS ON TOP OF ROCK BLUFF


N/H

New Accessories

11" D. D. FIR DOUBLE BLAZED AND SCRIBED "WC 74 S 22 CS BT" BEARS S 71 1/2° E, 83.0 FT

8" D. D. FIR DOUBLE BLAZED AND SCRIBED "WC 74 S 21 CS BT" BEARS S 12 1/2° W 63.5 FT

Sketch of Monument, Accessories, and General Area

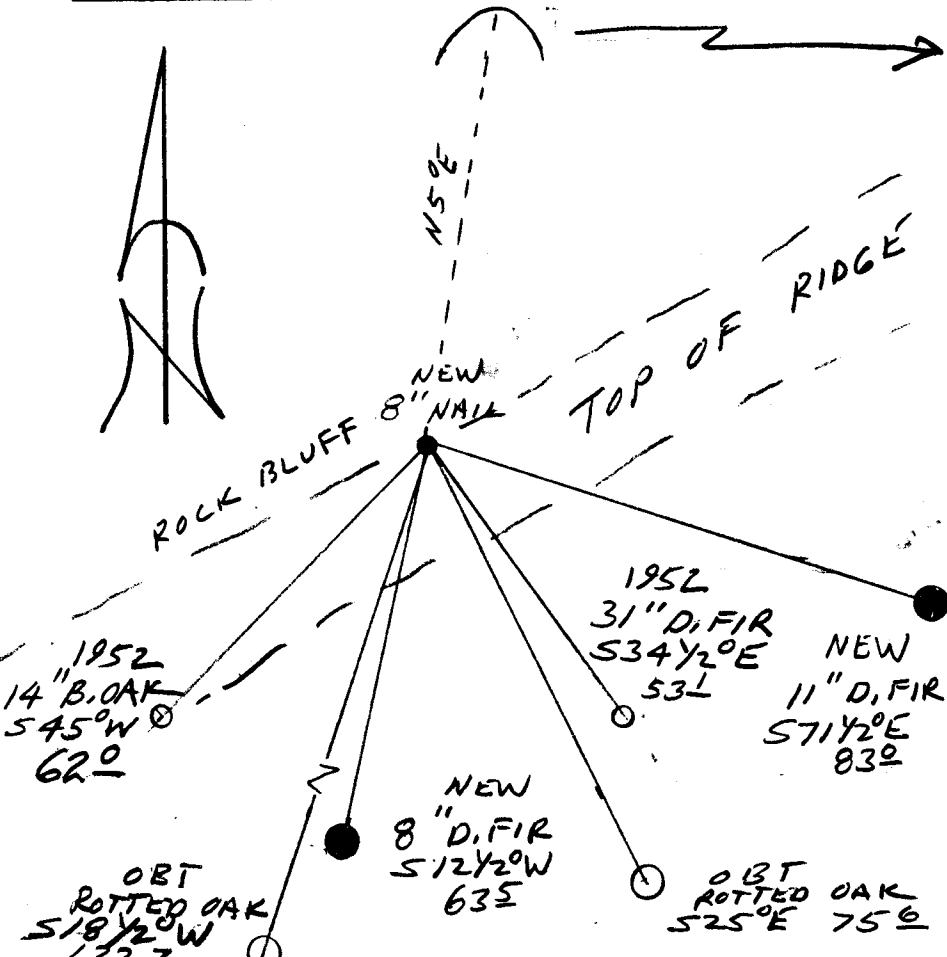

Location & Comments

CENTER OF KNOLL AT TOP OF GRAVEL PIT BEARS N 50° E

CORNER LIES ON TOP OF ROCK BLUFF NEAR NORTHERLY EDGE

Comp. Declin. 17 3/4° E  
Agency DCS  
Party Chief RANDALL W. SMITH  
Notekeeper  
Witnesses STEPHEN J. LAUSE

Address

Surveyor's Seal

REGISTERED PROFESSIONAL LAND SURVEYOR

Expires 6-30-98

OREGON JULY 25, 1990 RANDALL W. SMITH 2488