


GOVERNMENT CORNER RESTORATION FORM

Date: 12-5-97 By: RC

This survey consists of:

Township 25S Range 6W Sec. 11 County DOUGLAS
State OR Date 12-2-97 No. _____
Narrative: _____
Corner Rpt: 64/78-32

Corner Designation

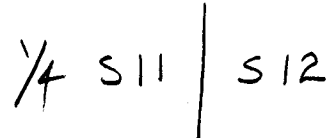

DOUGLAS COUNTY SURVEYOR

- Condition Report Only
- Not Found
- Renewed
- Unrecorded
- Surveyed In
- Referenced Out

Previous Renewals 1963 DCSO

Monument(s) Found: (Condition and Source)

2 1/2" BRASS CAP ON A 1 1/2" O.D. IRON PIPE BODY BENT NORTH, PROTRUDING 11" OUT OF GROUND. (1963)

COUNTY SURVEYORS OFFICE
T 25S
1/4 S | S
11 | 12
R 6W
1963

Accessories Found:

15" NOW 36" DIA. W. OAK WITH A PREVIOUSLY OPENED ROTTEN BLAZE NO SCRIBING VISIBLE, BEARS N 35° W, 235.9 FT AGREES WITH REC.) OBT

6" NOW DOUBLE TRUNK 11" DIA 10" HIGH W/OAK REC N 73° E, 201.2 FT, HITS SE TRUNK APPARENTLY CUT BELOW BLAZE. 1963

6" NOW 7" DIA. W. OAK BT HAS GROWN INTO A FENCE LINE, UNABLE TO SEE A BLAZE, BEARS N 50° W, 112.2 FT (AGREES WITH REC.) 1963

RENEWAL

Monument Detail

Monument Set (Procedure and Description)

BC/IP IS STRAIGHTENED AND RETURNED TO PLUMB POSITION, PROTRUDES 4" ABOVE GROUND.


N/A

New Accessories

9" DIA. W. OAK DOUBLE BLAZED AND SCRIBED "Y4S12CSBT" BEARS N70°E 19.6 FT. (NOTE THIS IS NW TRUNK OF 1963 BT).

11" DIA. W. OAK DOUBLE BLAZED AND SCRIBED "Y4S12CSBT" BEARS S56 1/2°E 43.6 FT

Sketch of Monument, Accessories, and General Area

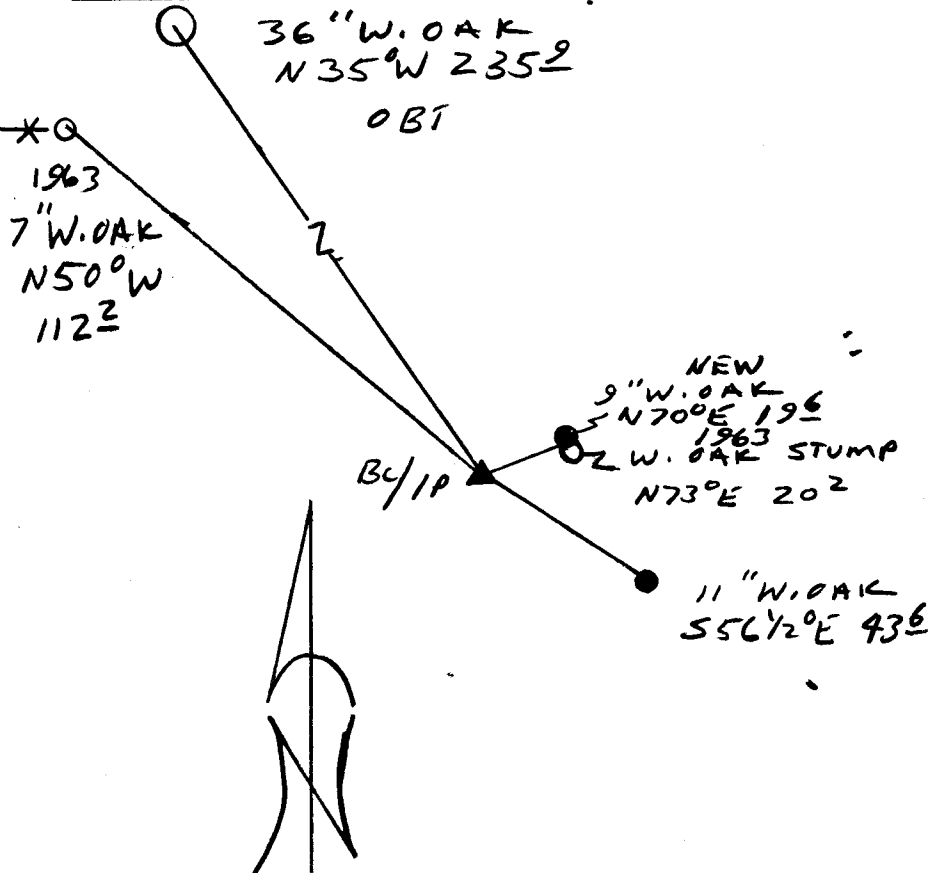

Location & Comments

FENCE LINE NOTED IN 1963 RENEWAL NOW NEARLY GONE

Comp. Declin. 17 3/4°E
Agency OCSO
Party Chief RANDALL W. SMITH
Notekeeper
Witnesses STEPHEN J. FLACK

Address

Surveyor's Seal

REGISTERED PROFESSIONAL LAND SURVEYOR

Randall W. Smith
EXPIRES 6-30-98

OREGON
JULY 25, 1980
RANDALL W. SMITH
2469