

GOVERNMENT CORNER RESTORATION FORM

Date: 12-9-97 By: ABC

Township 27S Range 1W Sec. 27 County DOUGLAS

This survey consists of:

State OR Date 12-4-97 No. \_\_\_\_\_

Corner Post: GS 64 | 78-34

Corner Designation

$\frac{1}{4}$  S27  
S34

DOUGLAS COUNTY

- Condition:  Only
- Not Found
- Renewed
- Unrecorded
- Surveyed In
- Referenced Out

Previous Renewals #116 1969 DC SO

MONUMENT DETAIL

Monument(s) Found: (Condition and Source)

2 1/2" BRASS CAP ON A 1 1/2" O.D. IRON PIPE PROTRUDES 1/8" ABOVE A MOUND OF STONE. #116

COUNTY SURVEYORS OFFICE  
T27S R1W

$\frac{1}{4}$  S27  
S34

1969

Accessories Found:

12" NOW 23" DIA. DEAD, BURNT CEDAR, WITH A FULLY HEALED SINGLE BLAZE, BEARS S 73° W, 15.2 FT (AGREES WITH REC.) OBT

8" NOW 25" DIA. DEAD, BURNT HEMLOCK, WITH A PARTIALLY HEALED BURNT BLAZE, ILLEGIBLE SCRIBING VISIBLE. BEARS N 71° W, 25.7 FT (AGREES WITH REC.) OBT

10" NOW 11" DIA. DEAD, BURNT D. FIR WITH A FULLY HEALED SINGLE BLAZE, BEARS S 6° W, 17.0 FT (AGREES WITH REC.) #116

Monument Set (Procedure and Description)


MORE STONE IS ADDED TO  
BASE OF MONUMENT, BC/IP  
NOW PROTRUDES 6" ABOVE  
2 1/2 FT DIA MOUND OF STONE.

N/A

New Accessories

24" DIA. D. FIR DOUBLE BLAZED AND SCRIBED "1/4 S 27 C S BT"  
BEARS N 79° W 88.3 FT  
31" DIA. D. FIR SINGLE BLAZED AND SCRIBED "1/4 S 37 C S BT"  
BEARS S 24° W 43.9 FT  
40" DIA 2 FT HIGH D. FIR STUMP WITH A PK NAIL  
SET THROUGH BT TAG ON TOP CENTER, BEARS  
N 51° E 4.5 FT

Sketch of Monument, Accessories, and General Area

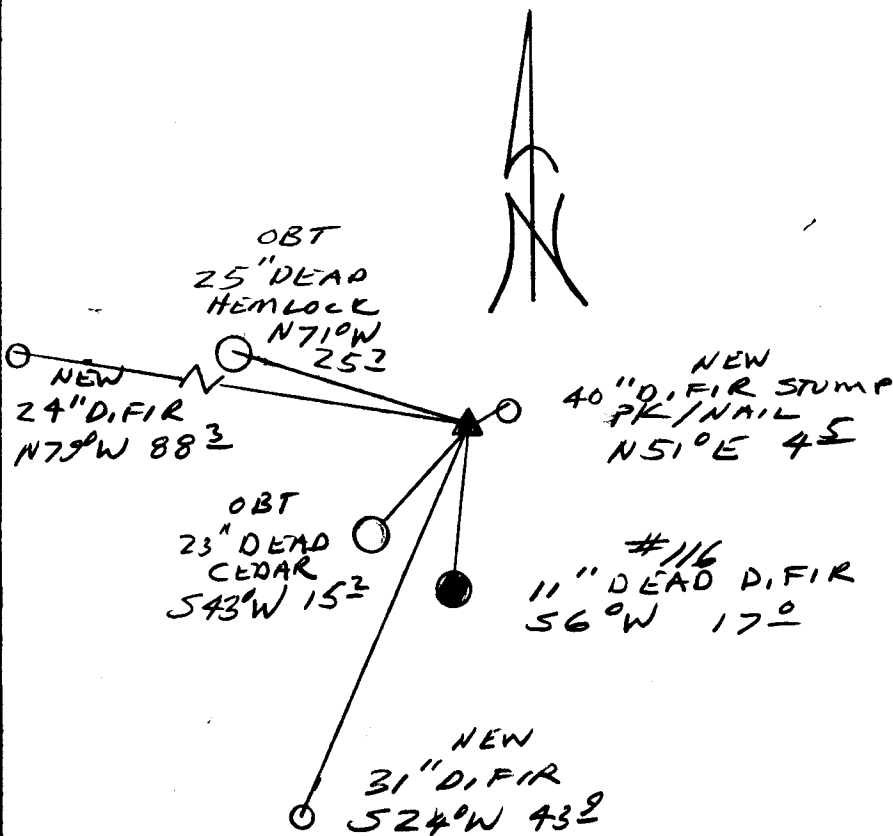

Location & Comments

CORNER LIES APPROX 250'  
SOUTH OF A CREEK AND  
100' NORTH OF A  
NW RUNNING RIDGE  
ON A STEEP NORTH  
SLOPE

Comp. Declin. 17740'   
Agency DCSG  
Party Chief RANDALL W SMITH  
Notekeeper [Signature]  
Witnesses STEPHEN J FLAISE

Address

Surveyor's Seal

REGISTERED  
PROFESSIONAL  
LAND SURVEYOR

[Signature]  
EXPIRES 6-30-98

OREGON  
JULY 25, 1990  
RANDALL W. SMITH  
2469