

GOVERNMENT CORNER RESTORATION FORM

Date: 12-15-97 By: PC

Township 25S Range 6W Sec. 12 County DOUGLAS

This survey consists of:

State OR Date 12-09-97 No. \_\_\_\_\_

Map: \_\_\_\_\_

Narrative: \_\_\_\_\_

Corner Designation

Corner Fpt: CS 64/78-36

$\frac{1}{4} \begin{array}{l} S 12 \\ S 13 \end{array}$

- DOUGLAS COUNTY  
 Condition RENEWED Only  
 Not Found  
 Renewed  
 Unrecorded  
 Surveyed In  
 Referenced Out

Previous Renewals 1963 DCSO

MONUMENT DETAIL

Monument(s) Found: (Condition and Source)

2 1/2" BRASS CAP ON A 1 1/2" O.D. IRON PIPE, PROTRUDES 6" ABOVE GROUND. 1963

COUNTY SURVEYORS OFFICE  
T 25S

$\frac{1}{4} \begin{array}{l} S 12 \\ S 13 \end{array}$  R  
6  
W  
1963

Accessories Found:

24" NOW 41" DIA. D. FIR WITH A FULLY HEALED SINGLE BLAZE, BEARS S55°E, 70.9 FT (AGREES WITH REC.) 1963

24" NOW 47" DIA. W. OAK WITH A FULLY HEALED DOUBLE BLAZE BEARS N 71° E, 526.4 FT (REC. N 71° E, 525.4 FT, DIST IS A FACE MEASUREMENT) ORT

Monument Set (Procedure and Description)

Monument Detail

NONE


N/A

New Accessories

TRIPLE TRUNKED MAPLE DOUBLE BLAZED AND SCRIBED "Y4S13CSBT"  
ON 10" DIA MIDDLE TRUNK, ROOT CROWN BEARS S 42° E, 64.3 FT

15" DIA. D. FIR DOUBLE BLAZED AND SCRIBED "Y4S13CSBT"  
BEARS S 35° W, 126.1 FT

Sketch of Monument, Accessories, and General Area

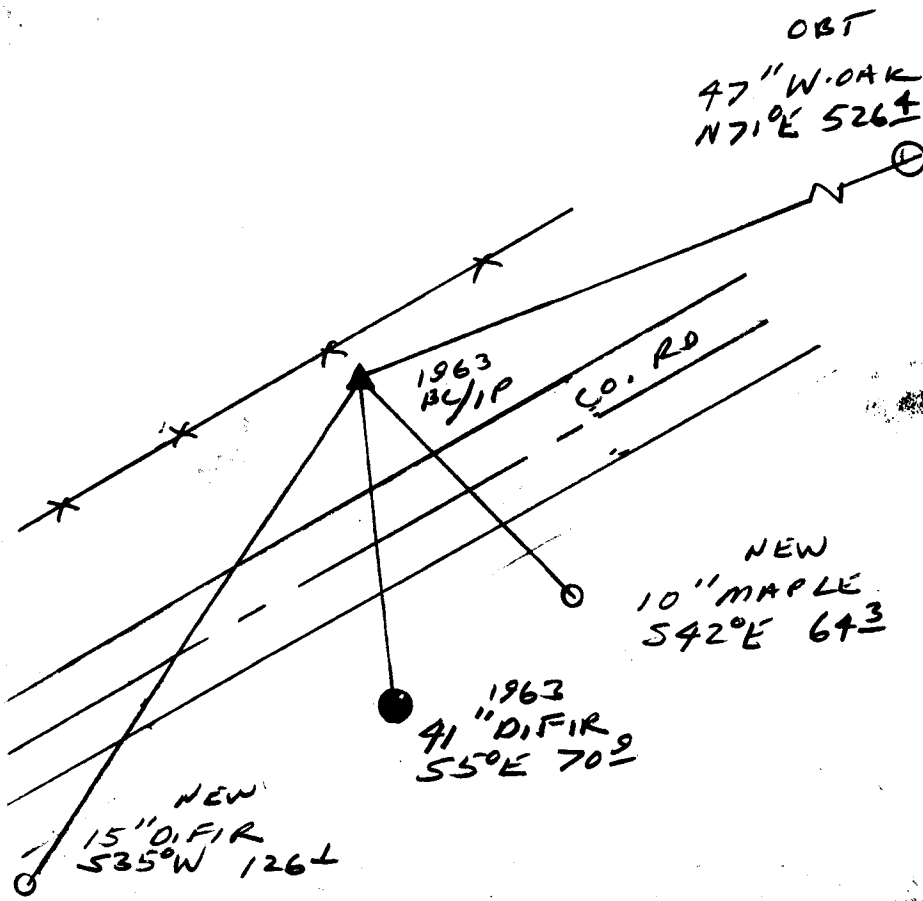

Location & Comments

CORNER LIES ON NORTH  
SIDE OF COUNTY ROAD  
3 FT SOUTH OF R/W FENCE

NO TREES AVAILABLE  
NORTH

Comp. Declin. 17 3/4° E  
Agency DCSO  
Party Chief RANDALL W. SMITH  
Notekeeper [Signature]  
Witnesses STEPHEN J. FLAUSE

Address

Surveyor's Seal

REGISTERED  
PROFESSIONAL  
LAND SURVEYOR

*Signature*  
EXPIRES 6-30-99

OREGON  
JULY 25, 1980  
RANDALL W. SMITH  
2489