

GOVERNMENT CORNER RESTORATION FORM

Township 24S Range 6W Sec. 17 County DOUGLAS  
State OR Date 12-11-97 No. \_\_\_\_\_  
Corner Designation \_\_\_\_\_

Date: 1-5-98 By: JC  
This survey consists of:  
Map: \_\_\_\_\_  
Narrative: \_\_\_\_\_  
Corner Rpt: 64/78-38

$\frac{1}{4} \frac{517}{520}$

Condition Report  
Not Found \_\_\_\_\_  
 Renewed \_\_\_\_\_  
Unrecorded \_\_\_\_\_  
Surveyed In \_\_\_\_\_  
Referenced Out \_\_\_\_\_

DOUGLAS COUNTY SURVEYOR

Previous Renewals 1959 DCSO

Monument(s) Found: (Condition and Source)  
2 1/2" DIA. BRASS CAP ON A 1 1/2" OR IRON PIPE PROTRUDES 15" ABOVE GROUND (1959)

COUNTY SURVEYORS OFFICE

$\frac{1}{4} \frac{517}{520}$

T24S R6W  
1959

Accessories Found:

19" NOW 24" DIA. 10' HIGH CEDAR SNAG WITH A PREVIOUSLY OPENED BLAZE, ILLEGIBLY SCRIBING VISIBLE, BEARS 520°E, 21.1 FT (AGREES WITH REC.) OBT  
12" NOW 12" DIA ROTTED AND BURNT 2' HIGH CEDAR STUMP, NO SCRIBING VISIBLE, BEARS N 30° W, 18.8 FT (AGREES WITH REC.) OBT  
11" NOW 11" 20' HIGH CEDAR SNAG WITH A UNMARKED DOUBLE BLAZE, SCRIBING VISIBLE  $\frac{1}{4}$  517 CS BT BEARS N 37° W, 50.3 FT (AGREES WITH REC.) 1959  
1959 NE BT NOT FOUND

Monument Set (Procedure and Description)

Monument Detail

NONE

N/A

11" DIA. D.FIR DOUBLE BLAZED AND SCRIBED "YAS17 CS BT" BEARS N6 1/2° W, 13.5 FT


New Accessories

10" DIA. D.FIR DOUBLE BLAZED AND SCRIBED "YAS20 CS BT" BEARS S60° E, 25.0 FT

7" DIA. I CEDAR DOUBLE BLAZED AND SCRIBED "YAS17 CS BT" BEARS N 87 1/2° W, 20.4 FT

6" DIA. WILLOW DOUBLE BLAZED AND SCRIBED "YAS20 CS BT" BEARS S7 1/2° E, 35.3 FT

Sketch of Monument, Accessories, and General Area

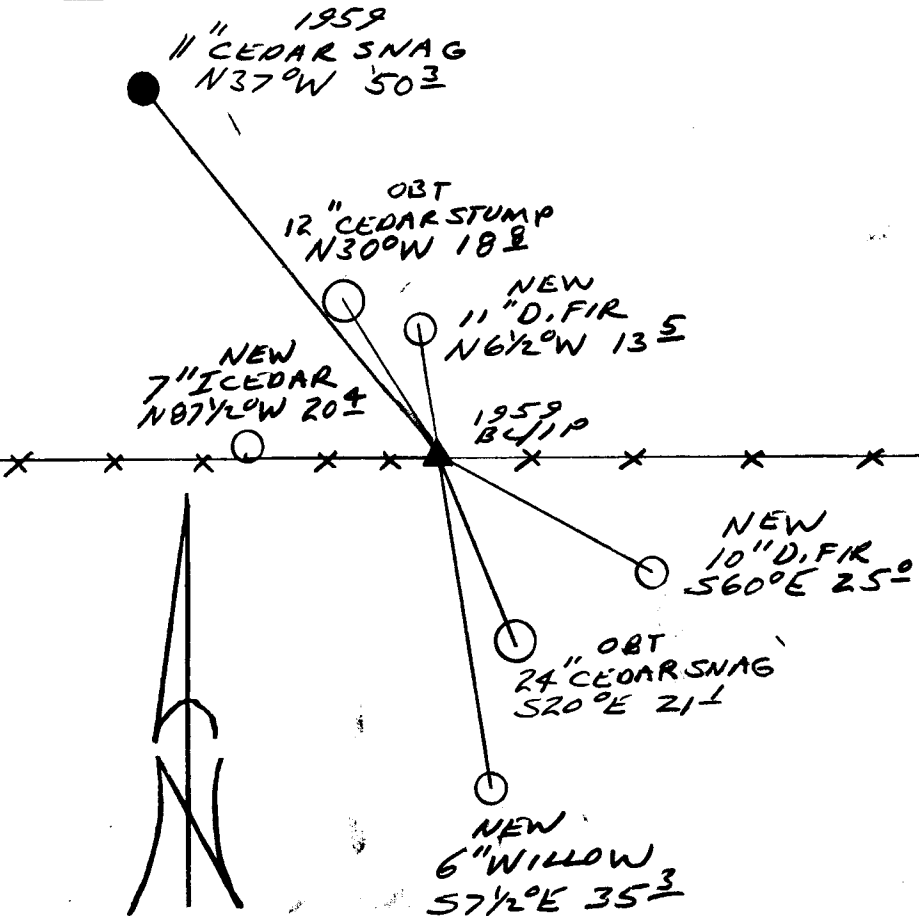

Location & Comments

CORNER LIES IN AN E-W FENCE LINE

Comp. Declin. 17 3/4° E  
 Agency DECO  
 Party Chief RANDALL W SMITH  
 Notekeeper [Signature]  
 Witnesses STEPHEN J FLAUSK

Address

Surveyor's Seal

REGISTERED  
 PROFESSIONAL  
 LAND SURVEYOR

Randall W Smith  
 EXPIRES 6-30-98

OREGON  
 JULY 25, 1990  
 RANDALL W. SMITH  
 2468