

GOVERNMENT CORNER RESTORATION FORM

Date: 1-5-98 By: X

This survey consists of:

Township 25S Range 4W Sec. County DOUGLAS

Map:

State OR Date 12-17-97 No.

Narrative:

Corner Rpt: 64/78-39

Corner Designation

DOUGLAS COUNTY SURVEYOR

INT. L
DLC 39

Condition Report Only

Not Found

Renewed

Unrecorded

Surveyed In

Referenced Out

Previous Renewals 1965 DCSO

MONUMENT DETAIL

Monument(s) Found: (Condition and Source)

2 1/2" DIA. BRASS CAP ON A
1 1/2" O.D. IRON PIPE PROTRUDING
4" ABOVE GROUND. (1965)

COUNTY SURVEYORS OFFICE

T25S

INT. L

39 | D.L.C.

R4W

1965

Accessories Found:

15" NOW 20" DIA. 6 FT HIGH CEDAR STUMP
WITH A PREVIOUSLY OPENED BLAZE, SCRIBING VISIBLE
"T" BEARS S55°E, 58.1 FT. (AGREES WITH REC.)
OBT

ORIG. NW BT NOT FOUND

8" NOW 21" DIA. D. FIR WITH A FULLY HEALED DOUBLE
BLAZE, BEARS S4°E, 18.6 FT. (REC. S70°E
18.6 FT) 1965

6" NOW 16" DIA. J. CEDAR WITH A FULLY HEALED DOUBLE
BLAZE, BEARS S79°E, 37.7 FT. (AGREES WITH REC.)
1965

C.S. File No. 64/78-39

RENEWAL

Monument Set (Procedure and Description)

Monument Detail

NONE

N/A


New Accessories

8" DIA. B. OAK DOUBLE BLAZED AND SCRIBED "INT L DLC 39 CS BT"
BEARS N 20° W, 69.2 FT

4" DIA. B. OAK DOUBLE BLAZED AND SCRIBED "X BT"
BEARS N 20 1/2° E, 15.0 FT

Sketch of Monument, Accessories, and General Area

Location & Comments

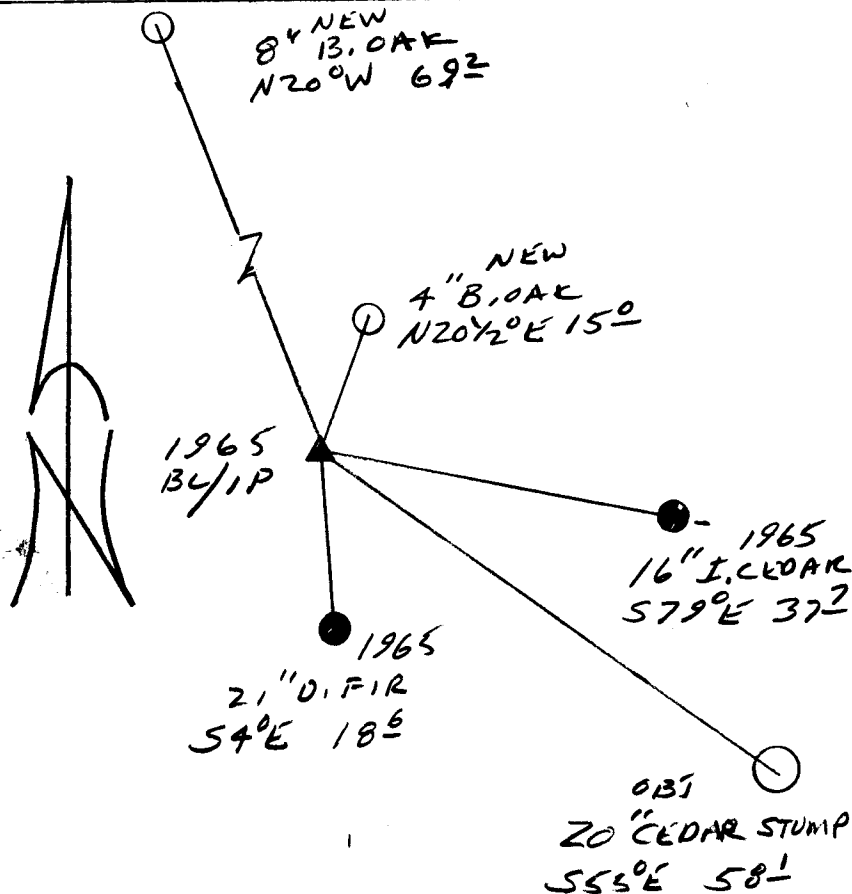

Comp. Declin. 17 3/4° E
 Agency KSQ
 Party Chief RANDALL W. SMITH
 Notekeeper [Signature]
 Witnesses STEPHEN J. FLJUSI

Address

Surveyor's Seal

REGISTERED
PROFESSIONAL
LAND SURVEYOR

[Signature]
EXPIRES 6-30-98

OREGON
JULY 25, 1990
RANDALL W. SMITH
2489