

GOVERNMENT CORNER RESTORATION FORM

Date: 1-15-98 By: JC

Township 295 Range 7W Sec. 29

County DOUGLAS Map: _____

This survey consists of: _____

State OR Date 1-12-98

No. _____ Narrative: _____

Corner Rpt: 64/79-2

Corner Designation

NW COR
DLC 38

DOUGLAS COUNTY

Condition Report Only

Not Found

Renewed

Unrecorded

Surveyed In

Referenced Out

MONUMENT DETAIL

Previous Renewals 1936, 1954 + 1957 DLCSD

Monument(s) Found: (Condition and Source)

2 1/2" DIA. BRASS CAP ON A
1 1/2" DIA. IRON PIPE, PROTRUDES
5" ABOVE GROUND. 1954

COUNTY SURVEYORS OFFICE

COR

1954 NW
DLC 38

Accessories Found:

- 17" NOW 32" DIA I. CEDAR WITH A FULLY HEALED
SINGLE BLAZE, BEARS S 26° E, 47.9 FT
(AGREES WITH REC.) 1954
- ~~40" NOW 47" DIA I. CEDAR, POSSIBLY BARK~~
~~SCRIBING ON FEET BARK DIA SCRIBING N 15° W~~
~~BEARS S 28° W, 20.0 FT (AGREES WITH REC.) 1954~~
- 12" NOW 14" DIA 2 FT HIGH ROTTED D. FIR STUMP
WITH BARK SCRIBING VISIBLE "NW 238 BT"
BEARS N 83° W 9.5 FT (REC. PER 1936 N 83° W 8.9 FT
DIST. FITS BLAZE) 1936 (REC. 1957 N 81° W, 9.5 FT)
- 12" NOW 12" DIA 2 FT HIGH ROTTED AND TIPPED OUT
OF POSITION D. FIR STUMP NO SCRIBING VISIBLE
IS FOUND NEAR REC. POSITION " ~~S 56 1/4° E~~ S 56 1/4° E, 5.0 FT
1936
- 36" NOW 47" DIA I. CEDAR WITH FLAT BARK NO
BARK SCRIBING VISIBLE AND A FULLY HEALED
SINGLE BLAZE BEARS S 28° W 20.0 FT
AGREES WITH 1957 RECORD (S 26 1/2° W, 19 FT
REC FROM 1936, DIST FITS WELL AS A BLAZE MEASUREMENT)
PER 1936 + 1957

Monument Set (Procedure and Description)

Monument Detail

NONE


N/A

New Accessories

8" DIA. D. FIR DOUBLE BLAZED AND SCRIBED "NW DLC 38 CS BT"
BEARS S 83° E, 12.8 FT

8" DIA. D. FIR DOUBLE BLAZED AND SCRIBED "NW DLC 38 CS BT"
BEARS N 36° W, 8.0 FT

Sketch of Monument, Accessories, and General Area

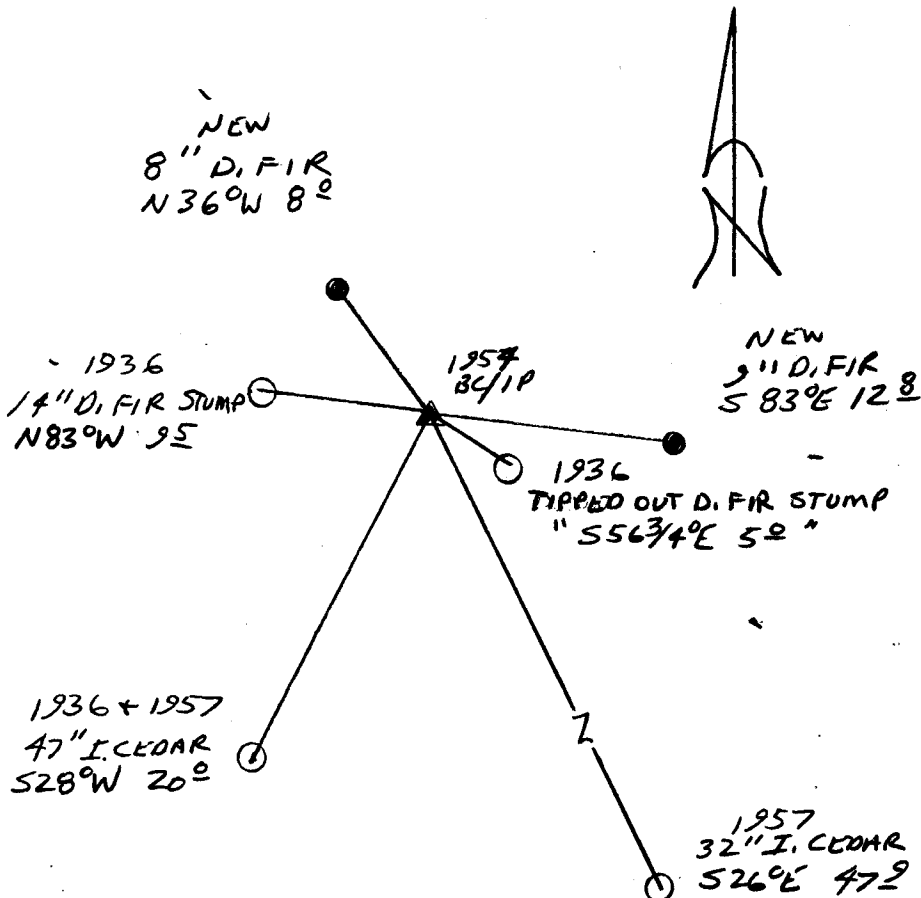

Location & Comments

Comp. Declin. 17 3/4° E
 Agency DESO
 Party Chief RANDALL W. SMITH
 Notekeeper STEPHEN J. FLANK
 Witnesses STEPHEN J. FLANK

Address

Surveyor's Seal

REGISTERED
PROFESSIONAL
LAND SURVEYOR

Randall W. Smith
EXPIRES 6-30-99

OREGON
JULY 25, 1990
RANDALL W. SMITH
2489