

Monument Set (Procedure and Description)

Monument Detail

NONE


N/A

New Accessories

13" DIA. CASCARA? DOUBLE BLAZED AND SCRIBED "1/4 S16 CS BT"
BEARS S 08° E, 33.8 FT

19" DIA. D. FIR DOUBLE BLAZED AND SCRIBED "1/4 S 2 C S BT"
BEARS N 31° W, 26.0 FT

Sketch of Monument, Accessories, and General Area

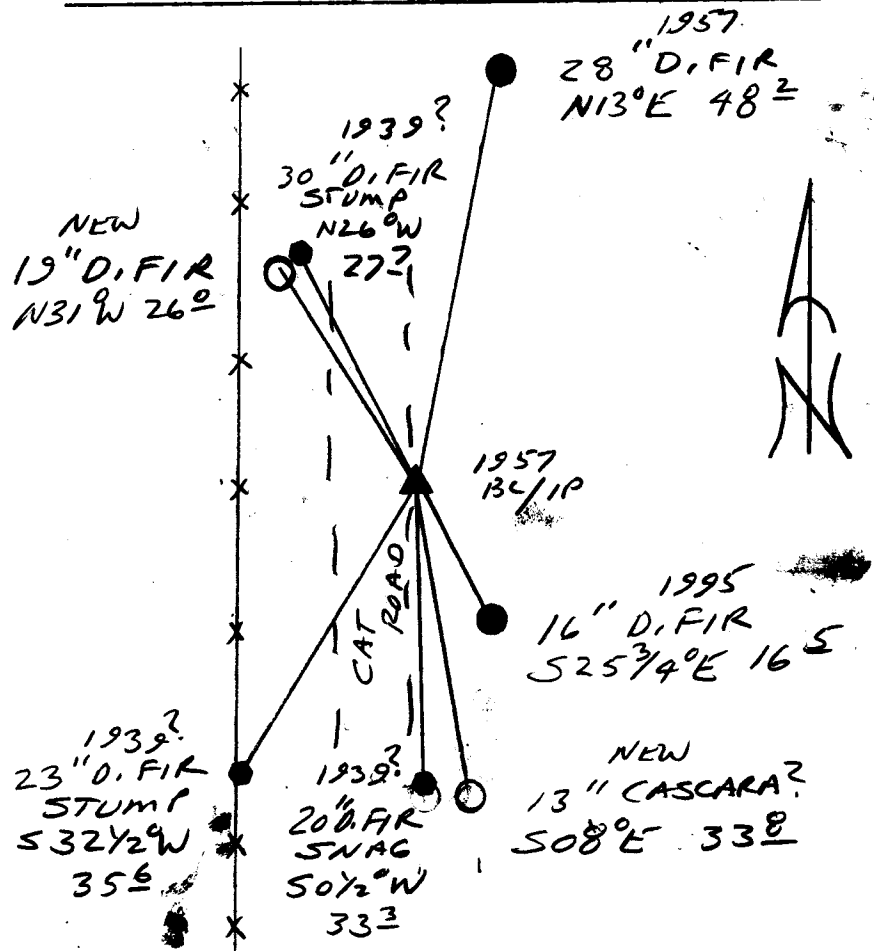

Location & Comments

CORNER LIES ALONG
EASTERN EDGE OF
A CAT ROAD, 21 FT
EAST OF A N-S
FENCE LINE

Comp. Declin. 17 3/4° E
Agency DLSD
Party Chief RANDALL W. SMITH
Notekeeper
Witnesses STEPHEN T. FLEUSE

Address

Surveyor's Seal

REGISTERED
PROFESSIONAL
LAND SURVEYOR

Randall W. Smith
APR 6-30-98

OREGON
JULY 20, 1990
RANDALL W. SMITH
2469