



RENEWAL

Monument Set (Procedure and Description)

Monument Detail

1943 13.6M BC/IP IS STRAIGHTENED AND RESET AT A POSITION DETERMINED FROM BT'S AS NOTED ON FRONT. PROTRUDES 5" ABOVE GROUND THE MARKS "DCSO RESET 1998" ARE ADDED TO BRASS CAP.

U.S. GENERAL LAND OFFICE

1/4

S24 S19  
DCSO RESET  
19 98


1943  
SURVEY

New Accessories

14" R. CEDAR DOUBLE BLAZED AND SCRIBED "Y4524CS BT" BEARS S20°W 29.9 FT

5" DIA. D. FIR DOUBLE BLAZED AND SCRIBED "Y4S19CS BT" BEARS S70°E 4.1 FT

Sketch of Monument, Accessories, and General Area

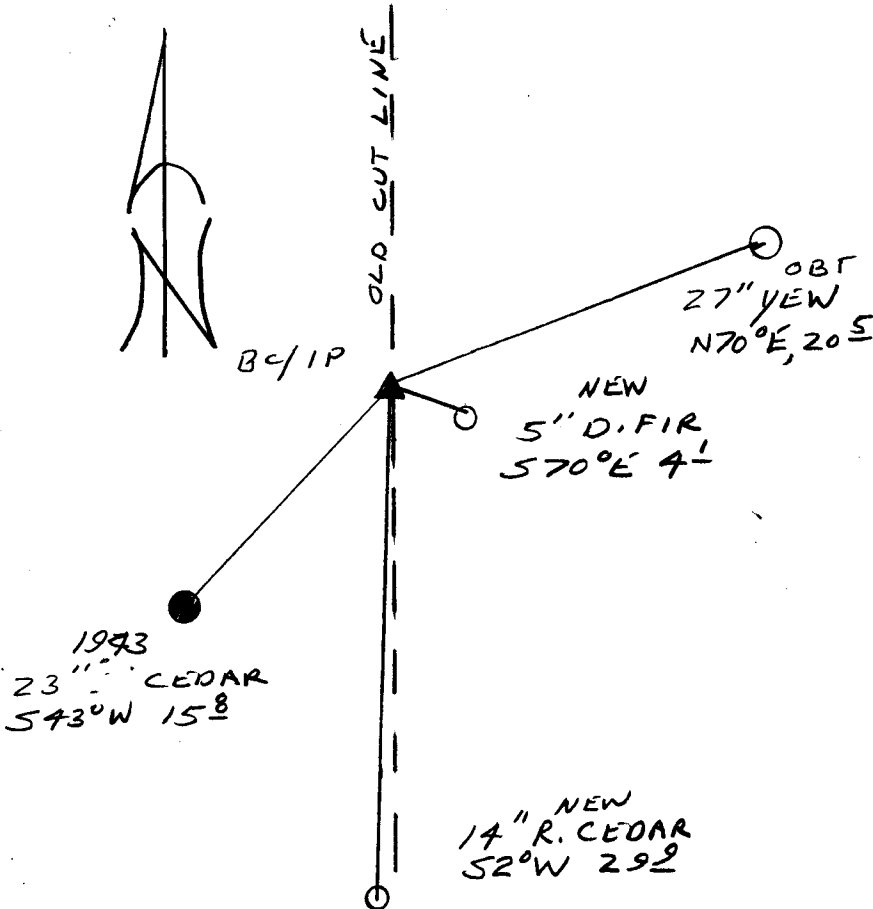

Location & Comments

Comp. Declin. 17 3/4° E  
Agency DCSO  
Party Chief RANDALL W. SMITH  
Notekeeper RANDALL W. SMITH  
Witnesses STEPHEN J. FAYSE

Address

Surveyor's Seal

REGISTERED PROFESSIONAL LAND SURVEYOR  
Randall W. Smith  
EXPIRES 6-30-98  
OREGON  
JULY 25, 1990  
RANDALL W. SMITH  
2489