

GOVERNMENT CORNER RESTORATION FORM

Date: 2-3-98 By: JC

Township 25S Range 3W Sec. 17

County DOUGLAS This survey consists of:

State OR Date 1-27-98 No. _____

Narrative: _____

Corner Designation

Corner Rpt: 6479-12

518 | 517

519 | 520

DOUGLAS COUNTY
Condition Report Only
SURVEYOR

- Not Found
- Renewed
- Unrecorded
- Surveyed In
- Referenced Out

Previous Renewals 1944 BLM, 1962 + 1966 DCSO

MONUMENT DETAIL

Monument(s) Found: (Condition and Source)

2 1/2" DIA. BRASS CAP ON A 2" O.D. IRON PIPE PROTRUDES 4" ABOVE GROUND, LEAN 12" NORTH (1944)

GENERAL LAND OFFICE

T 25S R 3W
518 | 517

519 | 520

1944
SURVEY

Accessories Found:

20" NOW ROTTED REMAINS OF A CEDAR NO SCRIBING OR BLAZES VISIBLE BEARS S43°W, 8.6 FT (AGREES WITH REC.) 1944

16" NOW 26" DIA. RICE CEDAR WITH A PARTIALLY HEALED BLAZE, ILLIGIBLE SCRIBING VISIBLE BEARS N8 1/2° E, 150.5 FT (AGREES WITH REC.) 1962

~~6" NOW 8" DIA. 1 FT HIGH ROTTED MAPLE STUMP NO SCRIBING OR BLAZES VISIBLE BEARS N75°W, 15.2 FT (AGREES WITH REC.) 1966 NW BT FROM 1966 RENEWAL NOW GONE~~

PLUMB POSITION OF LEANING FENCE CORNER BEARS S1°W, 65.3 FT (REC. S5°W, 65.3 FT) 1966

Monument Set (Procedure and Description)


13/1P PLUMBED NOW PROTRUS
6" ABOVE GROUND

N/A

New Accessories

- 11" DIA MAPLE DOUBLE BLAZED AND SCRIBED "T255 R3W S17CS BT"
BEARS N 73 1/2° E, 16.0 FT
- 18" DIA D. FIR DOUBLE BLAZED AND SCRIBED "T255 R3W S20CS BT"
BEARS S 70 1/2° E 41.7 FT
- 15" DIA D. FIR DOUBLE BLAZED AND SCRIBED "T255 R3W S19CS BT"
BEARS S 4 1/2° W, 56.5 FT

Sketch of Monument, Accessories, and General Area

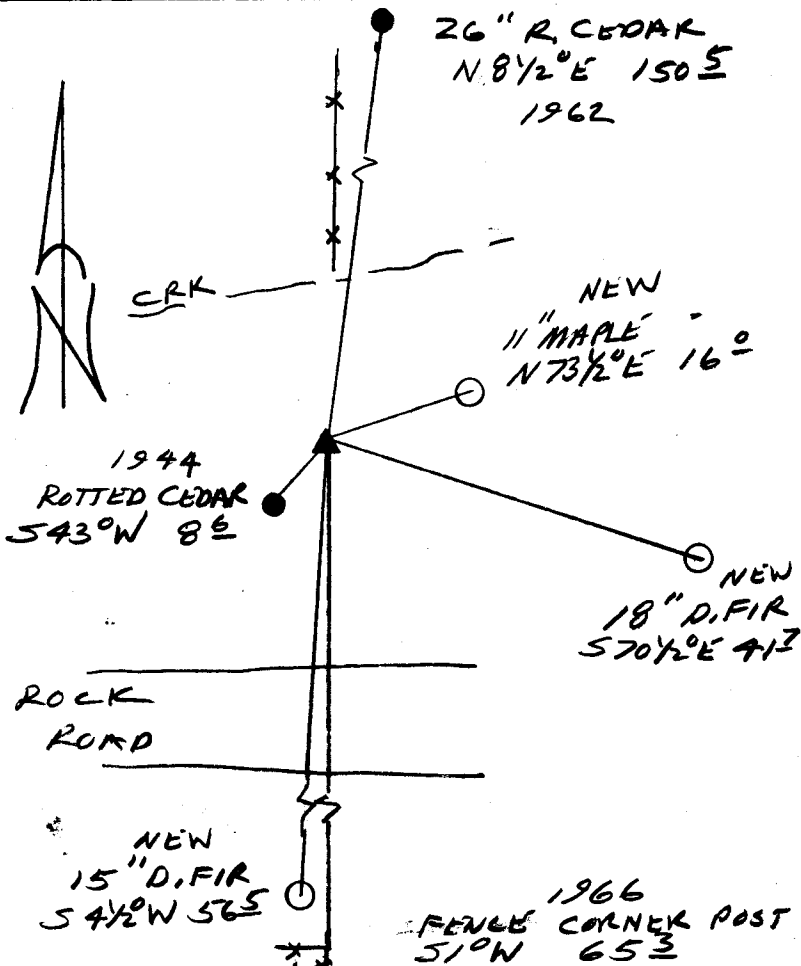

Location & Comments

Comp. Declin. 17 3/4° E
 Agency DCSO
 Party Chief RANDALL W. SMITH
 Notekeeper [Signature]
 Witnesses STEPHEN J. FLAVEL

Address

Surveyor's Seal

REGISTERED
 PROFESSIONAL
 LAND SURVEYOR

[Signature]
 EXPIRES 6-30-98

OREGON
 JULY 25, 1990
 RANDALL W. SMITH
 2469