

Monument Set (Procedure and Description)

Monument Detail

NONE

N/A


New Accessories

24" DIA. MADRONE DOUBLE BLAZED AND SCRIBED "INT SE DLG 52
CS BT" BEARS N 7° W, 14.0 FT

7" DIA. D. FIR DOUBLE BLAZED AND SCRIBED "INT SE DLG 52
CS BT" BEARS S 18° W, 14.0 FT

Sketch of Monument, Accessories, and General Area

Location & Comments

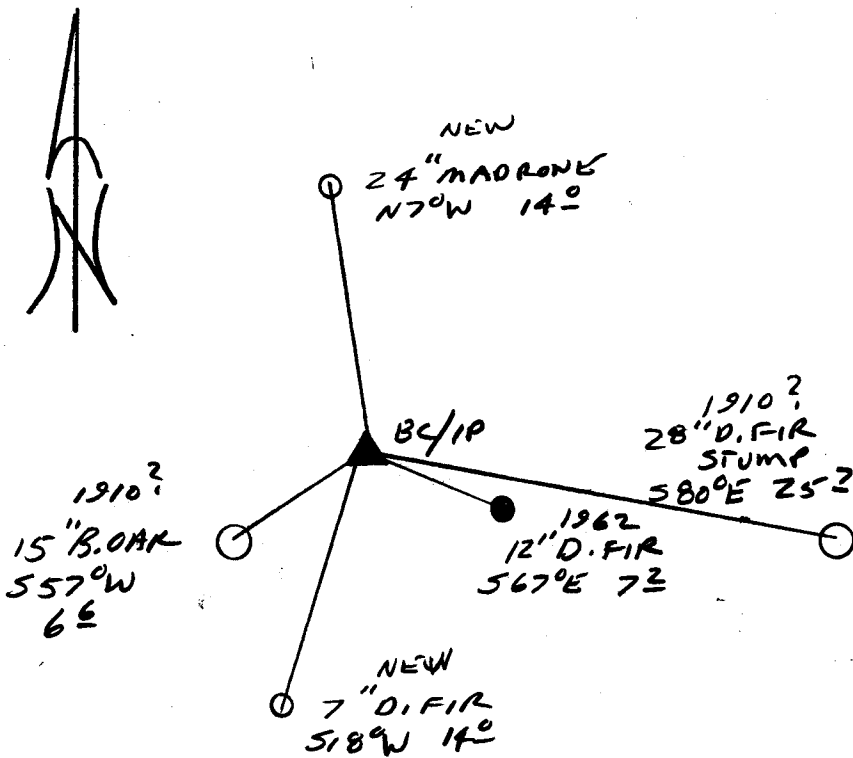

Comp. Declin. 17 3/4° E
 Agency DSSO
 Party Chief RANDALL W SMITH
 Notekeeper Randall W Smith
 Witnesses STEWART J FLEWEL

Address

Surveyor's Seal

REGISTERED
PROFESSIONAL
LAND SURVEYOR

Randall W Smith
APR 15 6-30-98

OREGON
JULY 25, 1990
RANDALL W. SMITH
2489