

GOVERNMENT CORNER RESTORATION FORM

Date: 2/12/98 By: X

Township 255 Range 6W Sec. 2

County DOUGLAS

This survey consists of:

State OR

Date 2-5-98

No. _____

Narrative: _____

Corner Rpt: 64/79-23

Corner Designation

$\frac{1}{4}$ S3 | S2

- DOUGLAS COUNTY
 Condition Report Only
 Not Found
 Renewed
 Unrecorded
 Surveyed In
 Referenced Out

Previous Renewals 1922 STEWART + 1962 OCS

MONUMENT DETAIL

Monument(s) Found: (Condition and Source)

2 1/2" DIA. BRASS CAP ON A
1 1/2" O.D. IRON PIPE, PROTRUDES
10" ABOVE GROUND. 1922

COUNTY SURVEYORS OFFICE

T 255

$\frac{1}{4}$ S 3 | S 2

26W

1962

Accessories Found:

NO OBJ'S FOUND

16" FIR NOW ROOT HOLE, BEARS N63°E, 32.0 FT
(AGREES WITH REC.) 1922

18" NOW ROTTED D.I.F.I.R. REMAINS, BEARS S52°W, 15.6 FT
(AGREES WITH REC.) 1922

4" NOW 7" DIA. MARKER WITH A FULLY HEALED DOUBLE
BLAZE BEARS S81°E, 36.4 FT (REC N78°E, 36.9 FT)
1922

18" NOW 26" DIA. D.I.F.I.R. WITH A FULLY HEALED DOUBLE
BLAZE BEARS S30°W, 93.0 FT (REC. S33°W
93.0 FT) 1962

Monument Set (Procedure and Description)

Monument Detail

NONE


N/A

New Accessories

7" DIA. B. OAK DOUBLE BLAZED AND SCRIBED "Y452 CS BT"
BEARS S 58 1/2° E, 15.9 FT

5" DIA. D. FIR DOUBLE BLAZED AND SCRIBED "Y453 CS BT"
BEARS S 58 1/2° W, 9.5 FT

Sketch of Monument, Accessories, and General Area

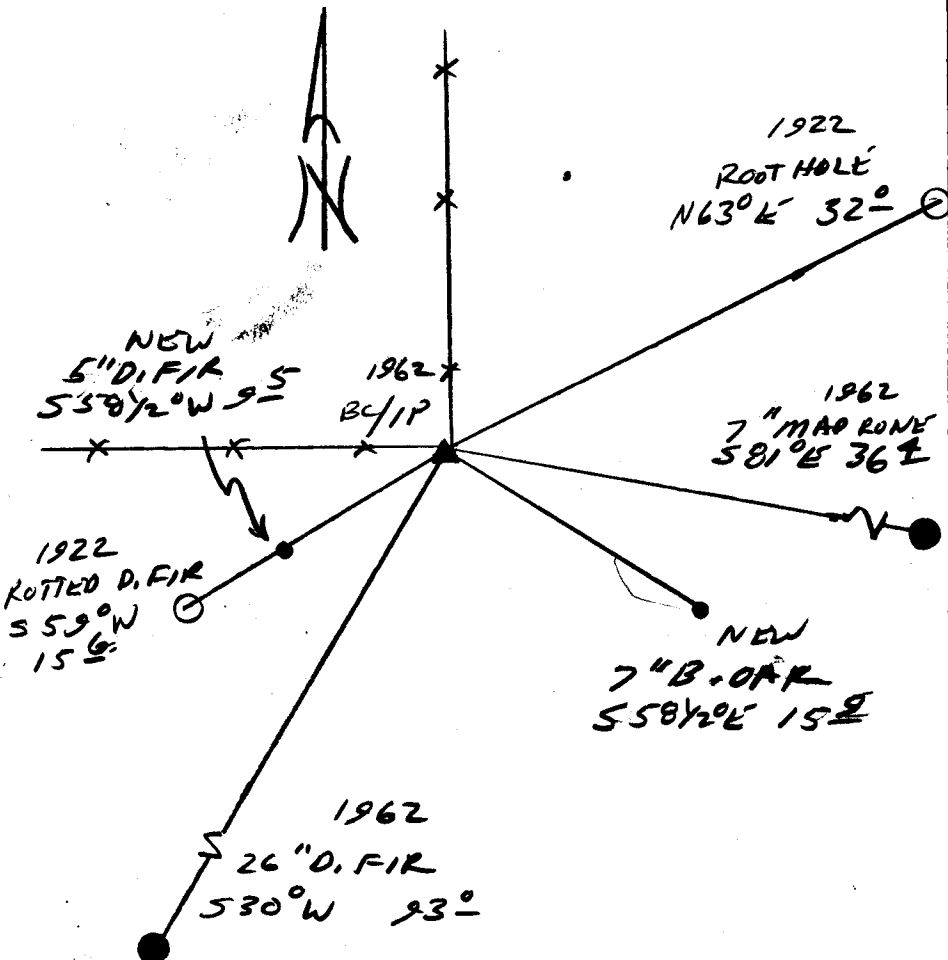

Location & Comments

CORNER LIES AT A
FENCE CORNER WITH
OLD FENCE RUNNING
NORTH + WEST

Comp. Declin. 17 3/4° E
Agency DCCO
Party Chief RANDALL W. SMITH
Notekeeper [Signature]
Witnesses STEPHEN T. FRAUSE

Address

Surveyor's Seal

REGISTERED
PROFESSIONAL
LAND SURVEYOR

[Signature]
EXPIRES 6-30-98

OREGON
JULY 25, 1990
RANDALL W. SMITH
2409