

GOVERNMENT CORNER RESTORATION FORM

Date: 2/10/98 By: DC

Township 30S Range 2W Sec. 2

County DOUGLAS Map: _____

This survey consists of:

State OR Date 2-10-98

No. _____ Narrative: _____

Corner Rpt: 64179-29

Corner Designation

DOUGLAS COUNTY

535
53/52

Condition Report Only

Not Found

Renewed

Unrecorded

Surveyed In

Referenced Out

Previous Renewals 1917 1968

MONUMENT DETAIL

Monument(s) Found: (Condition and Source)

2 1/2" DIA BRASS CAP ON A 1 1/2"
O.D. IRON PIPE FLUSH WITH
GROUND. LEANS 1 FT EAST (1968)

COUNTY SURVEYOR OFFICE
T29S R2W

12" X 8" X 6" STONE IS FOUND
LOOSE ON TOP OF GROUND LONG
WEST EDGE OF BC/1A STONE
IS MARKED WITH A "T" (ORIG
STONE)

535

53/52

T29S

1968

Accessories Found:

10" NW 22" DIA 3 1/2' HIGH D. FIR STUMP
PREVIOUSLY OPENED UNHEALED, NO SCRIBING VISIBLE,
BEARS S 66 1/2° W, 13.8 FT (REC S 66 1/2° W 15.2 FT)
03T

12" NW 12" DIA 3 FT HIGH HEMLOCK STUMP
WITH UNHEALED DOUBLE BLAZE SCRIBING VISIBLE,
"T29S R2W S35 CS BT" BEARS N 17° E, 13.6 FT
(REC N 14° E, 13.6 FT) 1968

7" NW 17" DIA D. FIR WITH FULLY HEALED DOUBLE
BLAZE, BEARS S 71° E, 27.5 FT
(REC S 71° E 26.5 FT) 1968

DESO ACROSS BC/1A

T29S R2W

534 | 535

S3

BEARS WEST 32.0 FT (REC. WEST 33.7 FT)

RENEWAL

Monument Detail

Monument Set (Procedure and Description)


RC/IP RETURNED TO PLUMB
POSITION, FLUSH WITH GROUND.
STONE IS LOOSE ALONG WEST
EDGE OF RC/IP

N/A

New Accessories

8" DIA D. FIR DOUBLY BLAZED AND SCRIBED "T30SR2WS3CS BT"
BEARS S62°W, 26.2 F7

Sketch of Monument, Accessories, and General Area

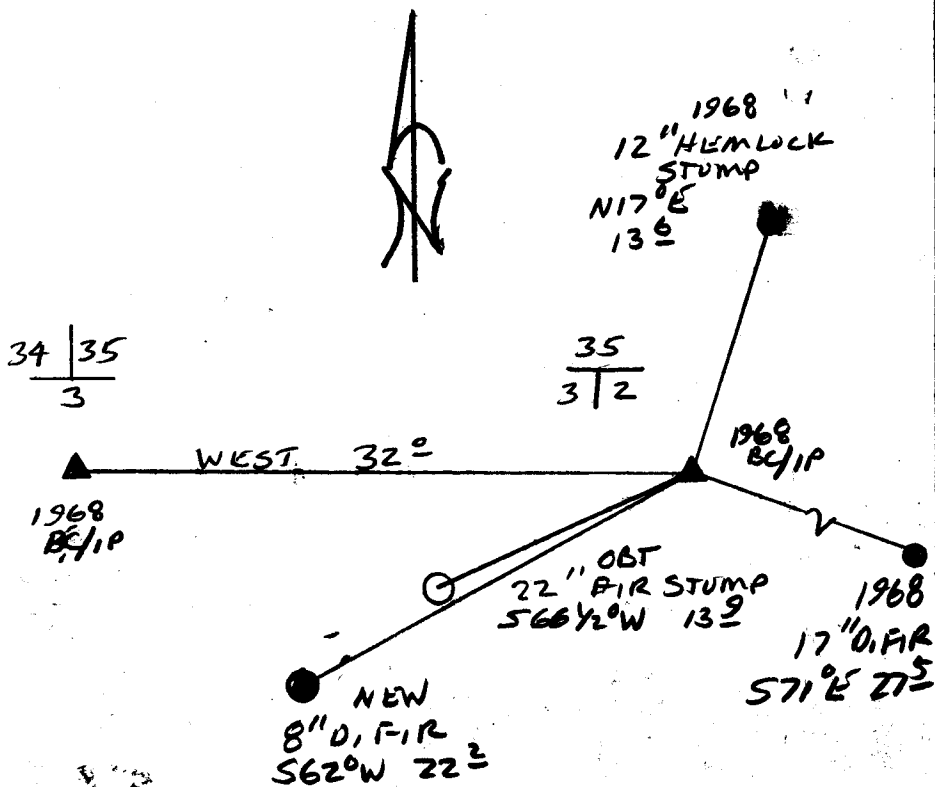

Location & Comments

METAL CAPS ARE ON
BT STUMPS

Comp. Declin. $17\frac{3}{4}^{\circ} E$
Agency DCSO
Party Chief RANDALL W SMITH
Notekeeper [Signature]
Witnesses STEPHEN J FLAISE

Address

Surveyor's Seal

REGISTERED
PROFESSIONAL
LAND SURVEYOR

[Signature]
EXPIRES 6-30-98

OREGON
JULY 25, 1990
RANDALL W. SMITH
2489