

GOVERNMENT CORNER RESTORATION FORM

Date: 2-25-98 By: JC

This survey consists of:

Township 25S Range 3W Sec. 6

County DOUGLAS Map: _____

State OR Date 1-22-98

No. _____

Narrative: _____

Corner Rpt: 6479-34

Corner Designation

1/4 S1/S6

DOUGLAS COUNTY
SURVEYOR

- Condition Report Only
- Not Found
- Renewed
- Unrecorded
- Surveyed In
- Referenced Out

Previous Renewals 1944 BLM, 1964 DCSO

Monument(s) Found: (Condition and Source)

2 1/2" DIA BRASS CAP ON A
1" O.D. IRON PIPE, PROTRUDES
12" ABOVE GROUND (1944)

U.S. GENERAL LAND OFFICE

1/4
S1/S6

1944
SURVEY

Accessories Found:

7" NOW 13" DIA DEAD MADRONE, WITH A PARTIALLY HEALED
SINGLE BLAZE, ~~BEARS S44°E, 83.2 FT~~ / SCRIBING
VISIBLE "1/4 S6 C", BEARS S44°E, 85.2 FT
(REC. S44°E 83.2 FT) 1944

5" NOW 21" DIA. D. FIR. WITH A FULLY HEALED
SINGLE BLAZE, BEARS S41°W, 191.9 FT
(AGREES WITH REC.) 1944

9" NOW 16" DIA D. FIR WITH A FULLY HEALED
DOUBLE BLAZE, BEARS N36°W, 19.9 FT
(REC. N36°W, 20.7 FT) 1964

Monument Set (Procedure and Description)

Monument Detail

NONE

N/A


New Accessories

12" DIA CEDAR, DOUBLE BLAZED AND SCRIBED "1/4 56 CS BT"
 BEARS N54°E, 27.0 FT

21" DIA. D.FIR, DOUBLE BLAZED AND SCRIBED "1/4 56 CS BT"
 BEARS S66°E, 44.7 FT

Sketch of Monument, Accessories, and General Area

Location & Comments

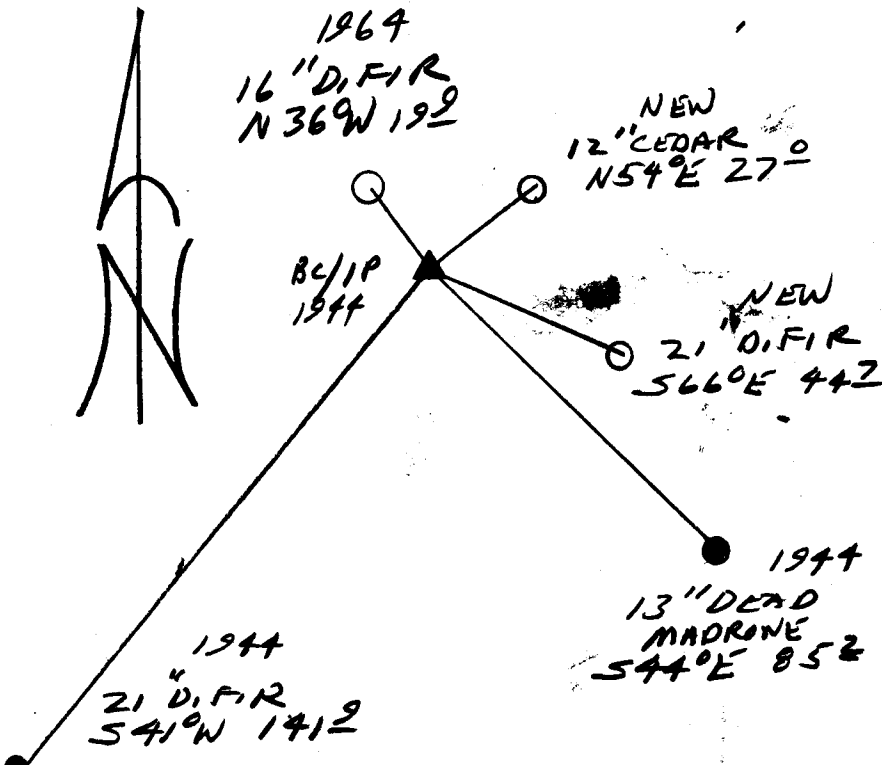

Comp. Declin. 17 3/4° E
 Agency OLSO
 Party Chief RANDALL W. SMITH
 Notekeeper [Signature]
 Witnesses STEPHAN J. FLAUS

Address _____

Surveyor's Seal

REGISTERED
 PROFESSIONAL
 LAND SURVEYOR

Randall W. Smith
 EXPIRES 6-30-98

OREGON
 JULY 26, 1980
 RANDALL W. SMITH
 2409