

RENEWAL

Monument Set (Procedure and Description)

2 3/8" DIA BRASS CAP ON A
 1 3/8" O.D. BY 32" LONG IRON
 PIPE IS SET AT FOUND
 HUB + TACK, PROVIDES 3"
 ABOVE GROUND.

Monument Detail

DOUGLAS COUNTY SURVEYORS

T 2 S S

1/4 S10/211

R G W
1998
OFFICE


New Accessories

8" DIA D.FIR DOUBLE BLAZED AND SCRIBED "1/4 S10 CS BT"
 BEARS S43°W, 12.5 FT

5" DIA. D.FIR DOUBLE BLAZED AND SCRIBED "X BT"
 BEARS N57°W, 25.9 FT

13" DIA W.OAK DOUBLE BLAZED AND SCRIBED "1/4 S11 CS BT"
 BEARS N11°E, 45.5 FT

Sketch of Monument, Accessories, and General Area

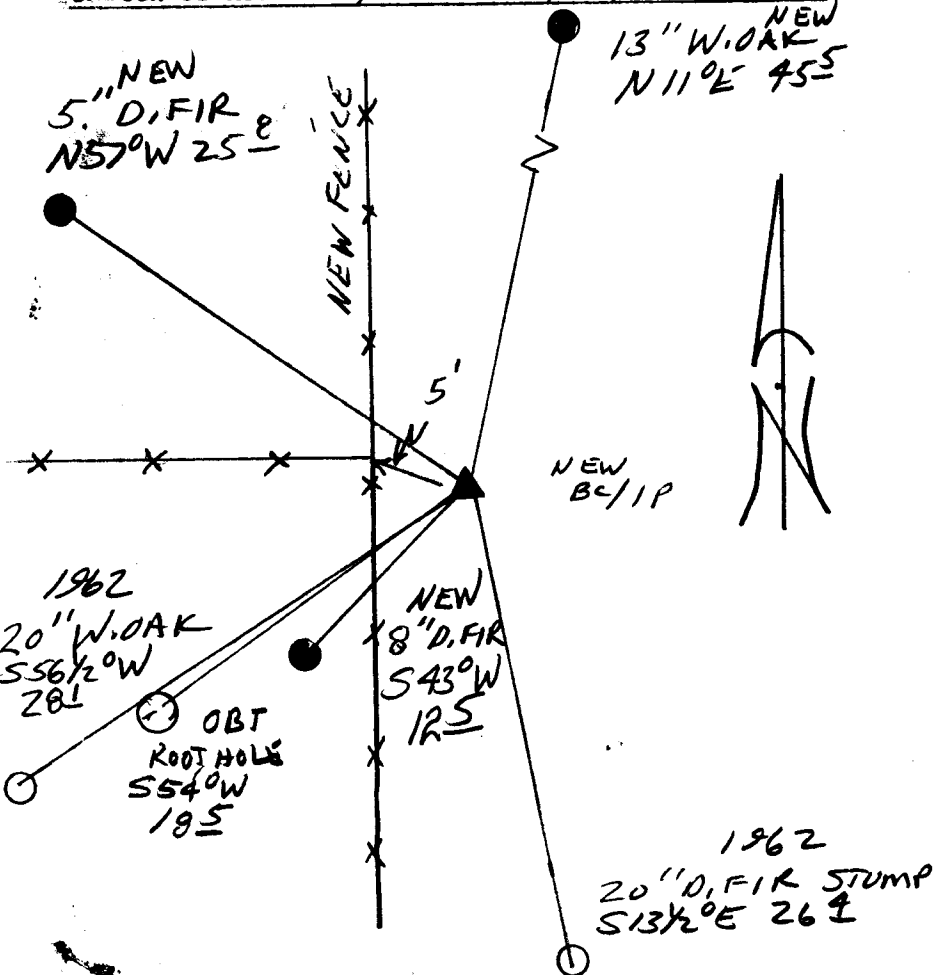

Location & Comments

Comp. Declin. 17 3/4° E
 Agency DCSO
 Party Chief RANDALL W. SMITH
 Notekeeper [Signature]
 Witnesses STEPHEN T. EVANS

Address

Surveyor's Seal

REGISTERED
 PROFESSIONAL
 LAND SURVEYOR

[Signature]
 EXPIRES 6-30-98

OREGON
 JULY 25, 1990
 RANDALL W. SMITH
 2489