

FILED

Date: 9-14-95 By: AD

This survey consists of:

Map: _____

Narrative: _____

Corner Rpt: CS 65/1-1

OREGON CORNER RESTORATION FORM

Section 29 Township 24S Range R8W

County DOUGLAS Date July 1995

Corner Designation _____

DOUGLAS COUNTY
SURVEYOR

- Condition Report Only
- Not Found
- Renewed
- Unrecorded
- Surveyed In
- Referenced Out

Previous Renewals/Surveys, etc. _____

Gov't NOTES PG 1332

Monument(s) & Accessories Found: (Condition and Source)


STONE, BLM BCIP

FIR, 36", S27°E, 45²ft, - TREE IS DOWN

FIR STUMP, 12", N76W, 48²ft - Cut Low

Monument Detail

Sketch

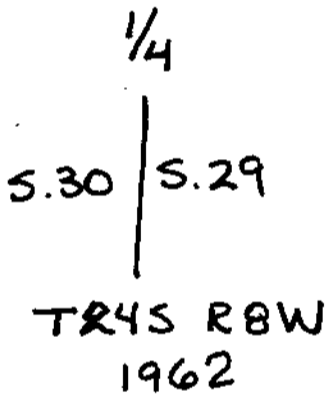

Monument Set (Procedures and Description)

New Accessories

W. FIR, 12", N70E, 43¹ft, scribed "1/4 S BT"

CHINQUAPIN, 5", S17W, 9²ft, scribed "1/4 S. BT"

HEMLOCK, 16", S33E, 17²ft, scribed "1/4 S BT"

FIR, 4", N62W, 9²ft, scribed "1/4 S BT"

Location & Comments

Surveyor's Seal

Compass Declination _____

Firm/Agency _____

ROSEBURG FOREST PRODUCTS


Address P.O. Box 1088

Roseburg OR 97470

Party Chief Bill Olson

Notes _____

Witness Ralph McManis

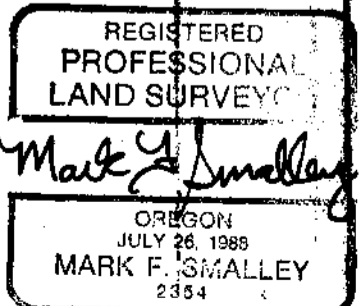

C.S. File No. CS 65/1-1

RENEWS 6/30/96

X C RENEW 109