

FILED

Date: 5-7-96 By: JP

This survey consists of:

Map: _____

Narrative: _____

Corner Rpt: C.S. 65/2-6

OREGON CORNER RESTORATION FORM

Section 28 Township 21S Range 4W

County Douglas Date 4/12/95

DOUGLAS COUNTY SURVEYOR

Corner Designation

NW 1/4 Corner

- Condition Report Only
- Not Found
- Renewed
- Unrecorded
- Surveyed In
- Referenced Out

Previous Renewals/Surveys, etc.

Eimstad & Assoc. for J.H. Baxter & Co., Charles Beecher, Giustina Bra
C.S. 1184-75 dated May 1980


Monument(s) & Accessories Found: (Condition and Source)

5/8" Rebar - okay
11" Chinquapin S53W 17.9' - down & out of position
9" Fir N27E 6.9' - down & out of position

All set by Eimstad-Survey 1184-75 dated 1980

Monument Detail

Sketch

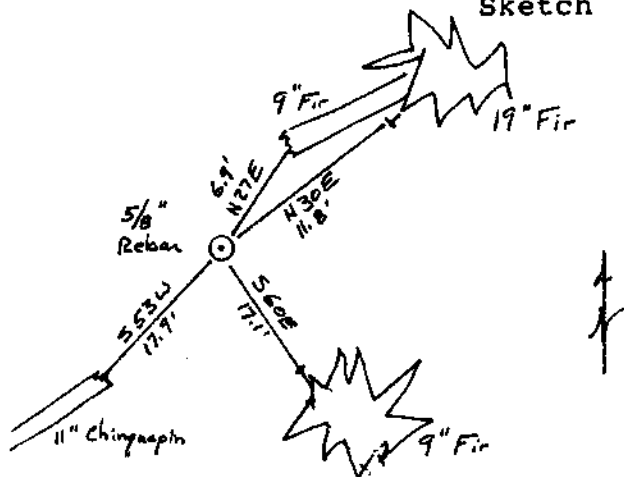

Monument Set (Procedures and Description)

New Accessories

19" Fir N30E 11.8 ft to 'W' nail
9" Fir S60E 17.1 ft to 'W' nail

Location & Comments

Work performed for
Weyerhaeuser Co.

Compass Declination 20°E

Firm/Agency Baker & Assoc.
Surveyors

Address 1385 Oak St. #3
Eugene OR 97401

Party Chief Pat Twin

Notes Spencer Noland

Witness _____

Surveyor's Seal

REGISTERED PROFESSIONAL LAND SURVEYOR

Daniel W. Baker
OREGON
JULY 16, 1982
DANIEL W. BAKER
1978

EXP 12/31/95
C.S. File No. C.S. 65/2-6