

BAKER AND ASSOCIATES
1385 OAK ST. SUITE #3
EUGENE, OR 97401

RESTORED CORNER

INDEX NO. _____

CORNER PROPERTY CORNER NORTH OF SOUTHWEST 1/16 CORNER SECTION 14, T.22 S., R.5 W., W.M.
CORNER No. 5 of M119-39

FILED

Date: 5-29-96 By: JP

REESTABLISHMENT NOTES DATED: 8/10/94 BY: BAKER AND ASSOCIATES
EVIDENCE RECOVERED: _____

This survey consists of:

Map: M119-39

Narrative: _____

Corner Rpt: C.S. 65/2-7

CORNER SET: 5/8" X 30" REBAR W/ 2" ALUMINUM CAP
ACCESSORIES ESTABLISHED: 7" FIR, S 67-1/2 E, 46.8 FT. - SCRIBED "PCBT"
16" FIR, S 6 W, 28.8 FT. - SCRIBED "PCBT"
6 FT. METAL FENCE POST 1 FT. WEST

DOUGLAS COUNTY
SURVEYOR

REESTABLISHMENT NOTES DATED: _____ BY: _____
EVIDENCE RECOVERED: _____

CORNER SET: _____
ACCESSORIES ESTABLISHED: _____



REMONUMENTATION

DATE: 1/4/96 BY: DAN BAKER TITLE: PLS 1978 FIRM: BAKER & ASSOC.
EVIDENCE RECOVERED: 5/8" REBAR W/ ALUMINUM CAP FOUND OUT OF POSITION
7" FIR, S 67-1/2 E, LEANING BADLY
16" FIR, S 6 W, WIND BREAK

CORNER SET: 5/8" REBAR W/ ALUMINUM CAP FOUND OUT OF POSITION
ACCESSORIES ESTABLISHED: 18" FIR STUMP, N 40 E, 2.02 FT. TO SPIKE - SCRIBED "PCBT"
16" FIR STUMP, S 75 W, 13.25 FT. TO SPIKE - SCRIBED "PCBT"

OTHER INFORMATION: CORNER DISPLACED AND BEARING TREES OUT OF POSITION AFTER
WIND STORM OF DECEMBER 12, 1995. CORNER REPLACED IN POSITION
FROM EXISTING TRAVERSE HUBS AND ORIGINAL NOTES OF RECENT
SURVEY BY THIS COMPANY IN 1994. NEW BTS SET AS NOTED.

SECTION DIAGRAM

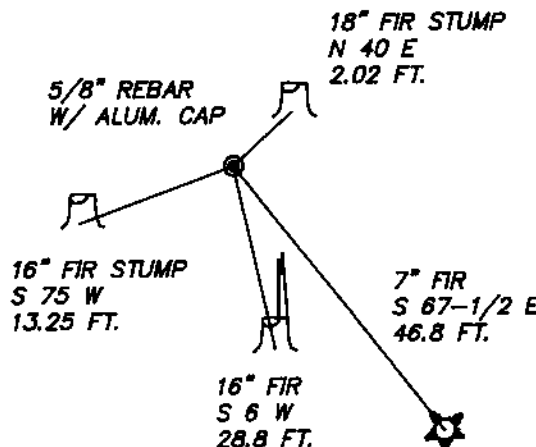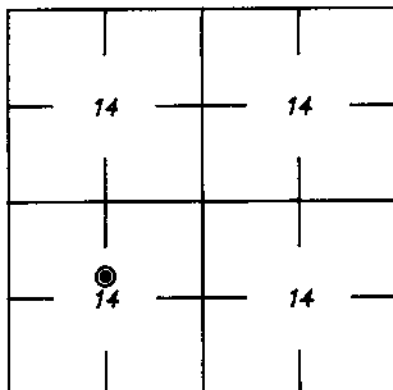

ORS 672-025

REGISTERED
PROFESSIONAL
LAND SURVEYOR

Daniel W. Baker

OREGON
JULY 18, 1982
DANIEL W. BAKER
1978

EXPIRES 12/31/97

C.S. File No. 65/2-7