

Date: 6-18-96 By: JP

This survey consists of:

Map: M 84-75

Narrative: \_\_\_\_\_

Corner Rpt: C.S. 65/2-8

OREGON CORNER RESTORATION FORM

Section 28 Township 21S Range 4W

County Douglas Date 4/12/95

DOUGLAS COUNTY  
SURVEYOR

Corner Designation

NW Corner Tax Lot #400  
(INST. # 88-12086)

- Condition Report Only
- Not Found
- Renewed
- Unrecorded
- Surveyed In
- Referenced Out

Previous Renewals/Surveys, etc.

Eimstad & Assoc. for J.H. Baxter & Co. Charles Beecher Gustina Bro.  
C.S. M 84-75 dated May 1980


Monument(s) & Accessories Found: (Condition and Source)

5/8" Rebar - okay

Set by Eimstad - Survey M 84-75 dated 1980

Monument Detail

Sketch

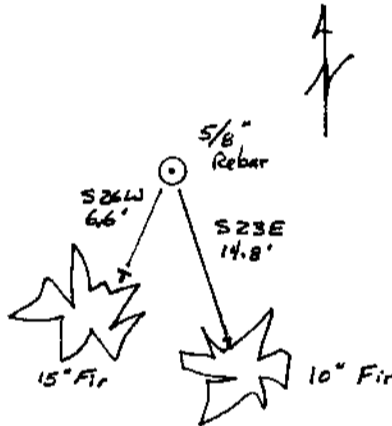

Monument Set (Procedures and Description)

\_\_\_\_\_  
\_\_\_\_\_  
\_\_\_\_\_

New Accessories

10" Fir S 23 E 14.8 ft to 'w' nail  
15" Fir S 26 W 6.6 ft to 'w' nail scribed "PCBT"

Location & Comments

Work performed for  
Weyerhaeuser Co.

Compass Declination 20°E

Firm/Agency Baker & Assoc.  
Surveyors

Address 1385 Oak St. Ste #3  
Eugene OR 97401

Party Chief Pat Irvin

Notes Spencer Neland

Witness \_\_\_\_\_

Surveyor's Seal

REGISTERED  
PROFESSIONAL  
LAND SURVEYOR

Daniel W. Baker  
OREGON  
JULY 16, 1982  
DANIEL W. BAKER  
1978

EXPIRES 12/31/97