

FILED

Date: 6-18-96 By: JP

This survey consists of:

Map: M84-75

Narrative: \_\_\_\_\_

Corner Rpt: CS 65/2-10

OREGON CORNER RESTORATION FORM

Section 28 Township 21S Range 4W

County Douglas Date 4/12/95

DOUGLAS COUNTY SURVEYOR

Corner Designation

SE Corner Tax Lot #400  
(INST. # 88-12086)

- Condition Report Only
- Not Found
- Renewed
- Unrecorded
- Surveyed In
- Referenced Out

Previous Renewals/Surveys, etc.

Eimstad & Assoc. for J.H. Baxter & Co., Charles Booher, Gristine Bro.  
C.S. M84-75 dated May 1980


Monument(s) & Accessories Found: (Condition and Source)

5/8" Rebar - okay

Set by Eimstad - Survey M84-75 dated 1980

Monument Detail

Sketch

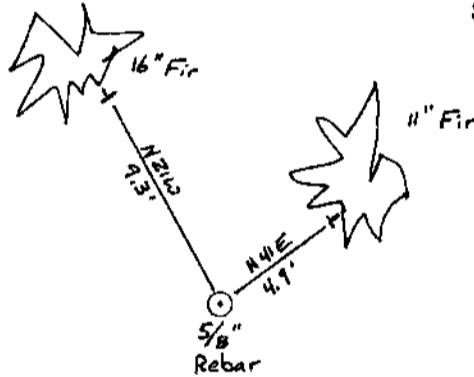

Monument Set (Procedures and Description)

New Accessories

11" Fir N41E 4.9 ft to 'W' nail  
16" Fir N21W 9.3 ft to 'W' nail

Location & Comments

Work performed for  
Weyenhausen Co.

Corner lies approx  
20 ft North and West  
of edge of Bear Ck  
Road.

Compass Declination 20°E  
Firm/Agency Baker & Assoc.  
Surveyors  
Address 1385 Oak St. #3  
Eugene OR 97401  
Party Chief Pat Twin  
Notes Spencer Noland  
Witness \_\_\_\_\_

Surveyor's Seal

REGISTERED  
PROFESSIONAL  
LAND SURVEYOR

Daniel W. Baker  
OREGON  
JULY 16, 1982  
DANIEL W. BAKER  
1978

Expires 12/31/97  
...S. File No. 65/2-10