

FILED

Date: 6-18-96 By: AP

This survey consists of:

Map: M 84-75

Narrative: _____

Corner Rpt: C.S. 65/2-11

OREGON CORNER RESTORATION FORM

Section 28 Township 21S Range 4W

County Douglas Date 4/12/95

DOUGLAS COUNTY
SURVEYOR

Corner Designation

SW Corner Tax Lot # 300
(INST. # 93-25957)

- Condition Report Only
- Not Found
- Renewed
- Unrecorded
- Surveyed In
- Referenced Out

Previous Renewals/Surveys, etc.

Eimstad & Assoc. for T.H. Baxter & Co., Charles Booher, Cristina Bro
C.S. M 84-75 dated May 1980


Monument(s) & Accessories Found: (Condition and Source)

5/8" Rebar - okay

Set by Eimstad - Survey M 84-75 dated 1980

Monument Detail

Sketch

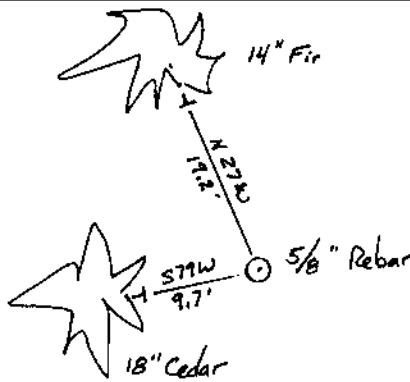

Monument Set (Procedures and Description)

New Accessories

14" Fir N 27 W 19.2 ft. to 'W' nail
18" Cedar S 71 W 9.7 ft. to 'W' nail

Location & Comments

Work performed for
Weyenhausen Co.

Corner lies approx
20' north of edge
of Bear Ck. Road.

Compass Declination 20°E
Firm/Agency Baker & Assoc.
Surveyors
Address 1385 Oak St. #3
Eugene OR 97401
Party Chief Pat Truin
Notes Spencer Island
Witness _____

Surveyor's Seal

REGISTERED
PROFESSIONAL
LAND SURVEYOR

Daniel W. Baker
OREGON
JULY 16, 1982
DANIEL W. BAKER
1976

Expires 12/31/97

C.S. File No. 65/2-11