

Fir

Date: 8-23-96 by: PC

This survey consists of:

Map: _____

Narrative: _____

Corner Rpt: CS 65/8-3

OREGON CORNER RESTORATION FORM

Section 36 Township 25S Range 8W

County DOUGLAS Date 4-22-96

DOUGLAS COUNTY
SURVEYOR

Corner Designation

26 | 25
35 | 36

- Condition Report Only
- Not Found
- Renewed
- Unrecorded
- Surveyed In
- Referenced Out

Previous Renewals/Surveys, etc. 1964 CADASTRAL

Monument(s) & Accessories Found: (Condition and Source)



IPBC

BTS: FIR 28" N70W 9² DOWN

HEMLOCK 22" N14³4E 13² GOOD COND. - HEALED FACE

FIR 8" S67¹2E 28⁴ SNAG - SCRIBE VISIBLE

Monument Detail

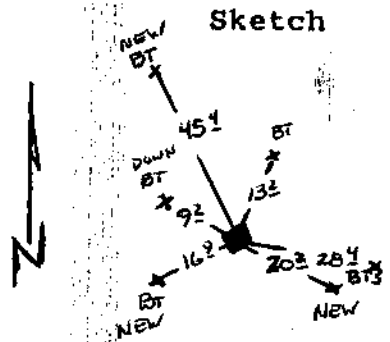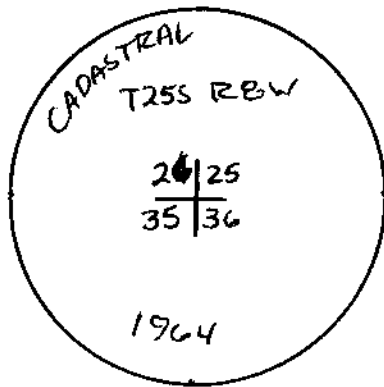

Monument Set (Procedures and Description)

New Accessories

BTS: FIR 6" N39W 45⁴ SCRIBED "S26 BT"

CEDAR 8" S50E 20² SCRIBED "S36 BT"

HEMLOCK 4" S54W 16² SCRIBED "S35 BT"

Location & Comments

Compass Declination 19°

Firm/Agency ROSEBURG

FOREST PRODUCTS

Address PO Box 1088

ROSEBURG OR. 97470

Party Chief BILL OLSON

Notes _____

Witness RALPH McMANIS

Surveyor's Seal

REGISTERED
PROFESSIONAL
LAND SURVEYOR

Mark F. Smalley

OREGON
JULY 26, 1988
MARK F. SMALLEY
2354

RENEWED 6/30/98

U.S. File No. 65/8-3