

FILED

Date: 8.23.96 By: BC

OREGON CORNER RESTORATION FORM

This survey consists of:

Section 36 Township 25S Range 8W
County DOUGLAS Date 4-22-96

Map: _____
Narrative: _____
Corner Rpt: CS 65/8-4

Corner Designation

DOUGLAS COUNTY SURVEYOR

25 1/4
36

- Condition Report Only
- Not Found
- Renewed
- Unrecorded
- Surveyed In
- Referenced Out



Previous Renewals/Surveys, etc. _____

Monument(s) & Accessories Found: (Condition and Source)

BTS: FIR 20" N80W 10⁶ SNAG
FIR 34" N45E 9² GOOD COND. - HEALED FACE
HEMLOCK 18" N58³4E 56⁴ GOOD COND. - HEALED FACE
FIR 24" S49¹2E 18³ GOOD COND. - HEALED FACE
1964 IPBC CADASTRAL

Monument Detail

Sketch

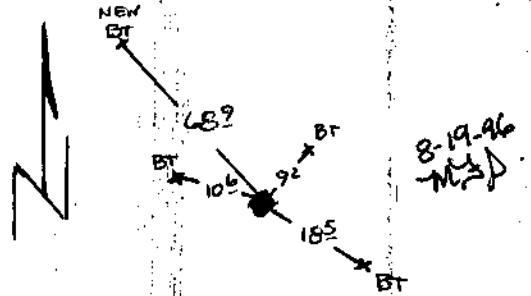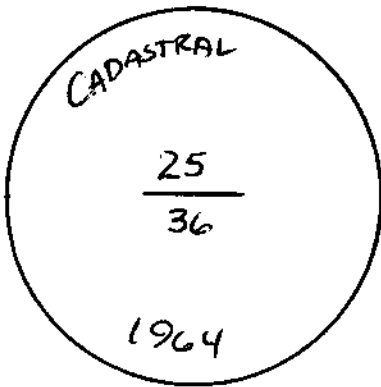

Monument Set (Procedures and Description)

New Accessories

BTS: 1/4 FIR N59W 68² SCRIBED "1/4 S BT"

Location & Comments

Surveyor's Seal

Compass Declination 20°
 Firm/Agency ROSEBURG FOREST PRODUCTS
 Address PO Box 1088 ROSEBURG OR 97470
 Party Chief BILL OLSON
 Notes _____
 Witness RALPH McMANIS



RENEW 6/30/98

C.S. File No. 65/8-4