

FILED

Date: 8-23-96 By: PC

This survey consists of:

Map: \_\_\_\_\_

Narrative: \_\_\_\_\_

Corner Rpt: CS 65/8-5

OREGON CORNER RESTORATION FORM

Section 36 Township 25S Range BW

County DOUGLAS Date 4-22-96

Corner Designation

35 | 36  
2 | 1

DOUGLAS COUNTY  
SURVEYOR

- Condition Report Only
- Not Found
- Renewed
- Unrecorded
- Surveyed In
- Referenced Out

Previous Renewals/Surveys, etc. \_\_\_\_\_


Monument(s) & Accessories Found: (Condition and Source)

1964 CADASTRAL IPBC


BIT: FIR 22" N38E 42LKS GOOD COND. - HEALED FACE

FIR 21" S84 1/4 E 57LKS GOOD COND. - HEALED FACE

Monument Detail

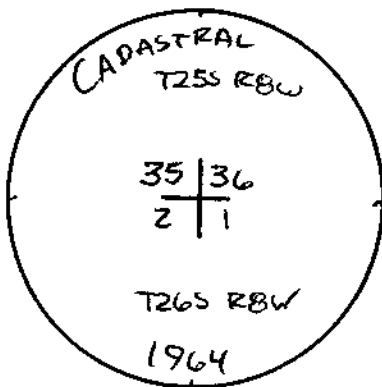

Sketch

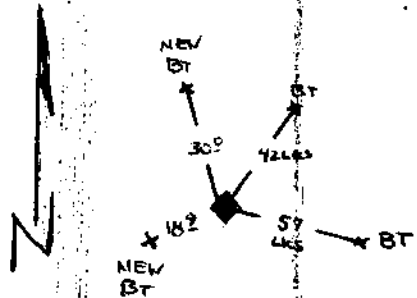

Monument Set (Procedures and Description)

New Accessories

BIT: FIR 8" N10W 30° SCRIBED "S35 BT"

HEMLOCK 6" S71W 18° SCRIBED "S2 BT"

Location & Comments

Compass Declination 20°

Firm/Agency ROSEBURG

FOREST PRODUCTS

Address PO Box 1088

ROSEBURG OR 97470

Party Chief BILL OLSON

Notes \_\_\_\_\_

Witness RALPH McMANIS

Surveyor's Seal

REGISTERED  
PROFESSIONAL  
LAND SURVEYOR

*Mark F. Smalley*  
OREGON  
JULY 28, 1988  
MARK F. SMALLEY  
2354

RENEWS 6/30/98

C.S. File No. 65/8-5