

FILED

Date: 12-16-96 By: X

This survey consists of:

OREGON CORNER RESTORATION FORM

Section 26 Township 32S Range 7W

County DOUGLAS Date 11-5-96

Map: _____

Narrative: _____

Corner Rpt: 65/8-19

DOUGLAS COUNTY SURVEYOR SC

Corner Designation

E 1/4 S26, T32S, R7W

- Condition Report Only
- Not Found
- Renewed
- Unrecorded
- Surveyed In
- Referenced Out

Previous Renewals/Surveys, etc. _____


Monument(s) & Accessories Found: (Condition and Source)

1978 BLM CAD IPBC
40" FIR N30W 34³ - STUMP
12" LIVE OAK N17E 24⁴ - 13" GOOD COND. PART HEALED FACE
10" S. PINE S24W 5³ - 13" GOOD HEALED FACE - 2 BRNGS ON TAG N29E! N24E

Monument Detail



Sketch

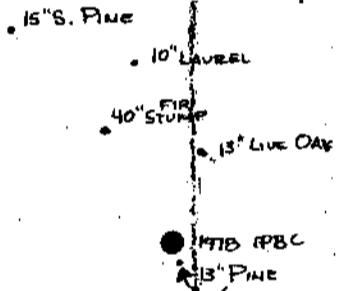

Monument Set (Procedures and Description)

New Accessories

Rts: 10" LAUREL N12W 48⁵ SCRIBED "E 1/4 S26 BT"
15" S. PINE N36W 69⁶ SCRIBED "E 1/4 S26 BT"

Location & Comments

CORNER ABOUT 70'
WEST OF RD - FLUSH
IN LOOSE SHALE

Compass Declination 20°
 Firm/Agency ROSEBURG FOREST PRODUCTS
 Address PO Box 1088
ROSEBURG OR 97470
 Party Chief BILL OLSON
 Notes BILL OLSON
 Witness RALPH McMANIS

Surveyor's Seal



RENEWS 6/30/98