



RENEWAL

Monument Detail

Monument Set (Procedure and Description)

BC/IP NOT SET AS I.P. FROM 1969 IS FIRM AND AREA AROUND CORNER IS ON A STEEP SLOPE.

N/A


New Accessories

- 19" DIA. D. FIR DOUBLE BLAZED AND SCRIBED "1/4 S 30 CS BT" BEARS N 67° W, 17.2 FT.
9" DIA. D. FIR DOUBLE BLAZED AND SCRIBED "1/4 S 31 CS BT" BEARS S 70° W, 24.0 FT.
6" DIA. I. CEDAR DOUBLE BLAZED AND SCRIBED "1/4 S 30 CS BT" BEARS N 65° E, 33.6 FT.
52" DIA. D. FIR SINGLE BLAZED AND SCRIBED "1/4 S 31 CS BT" BEARS S 79 1/2° E 40.8 FT

Sketch of Monument, Accessories, and General Area

Location & Comments

CORNER LIES ON A STEEP NORTH SLOPE ON A EAST-WEST CUT LINE

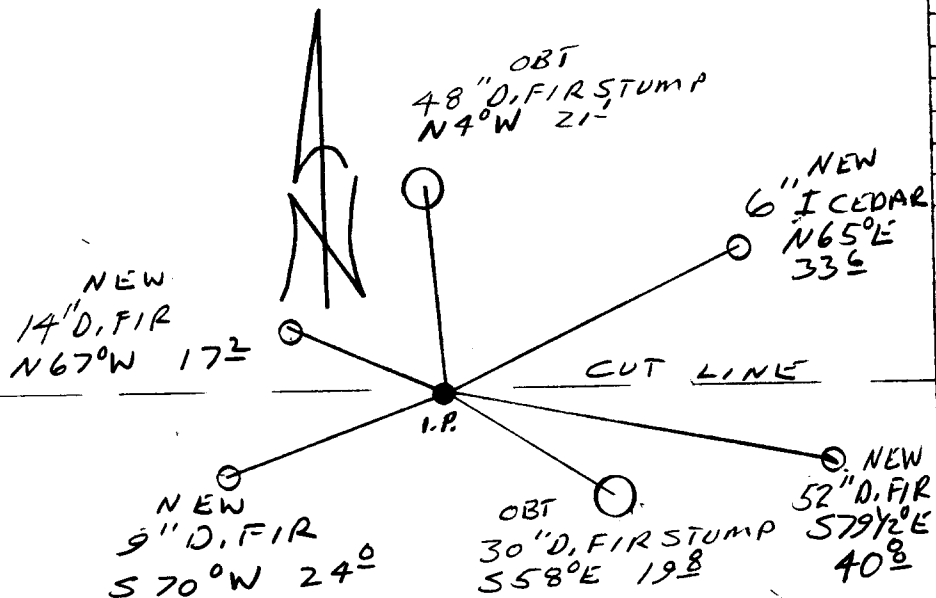

OLD GROWTH

Comp. Declin. 17 3/4° E
Agency DCSO
Party Chief RANDALL W. SMITH
Notekeeper Randall W. Smith
Witnesses STEPHEN J. FLAUSK

Address

Surveyor's Seal

REGISTERED PROFESSIONAL LAND SURVEYOR

Randall W. Smith
EXPIRES 6-30-98

OREGON
JULY 25, 1990
RANDALL W. SMITH
2468