

FILED

GOVERNMENT CORNER RESTORATION FORM

Date: 11-4-96 By: JP

This survey consists of:

Township 31S Range 6W Sec. 19

County DOUGLA Map: _____

State OR

Date 8-26-96

No. _____

Narrative: _____

Corner Rpt: 65/9-5

Corner Designation

S19 | S20
S30 | S29

DOUGLAS COUNTY SURVEYOR

- ____ Condition Report Only
- ____ Not Found
- Renewed
- ____ Unrecorded
- ____ Surveyed In
- ____ Referenced Out

MONUMENT DETAIL


PI # 200300

Previous Renewals 1960 CLIFFORD BRYDEN, 1966 DCSO

Monument(s) Found: (Condition and Source)

FOUND TIPPED ON SIDE POINTING SE,
4" DIA. IRON PIPE WITH FLANGES
3 FT BELOW GROUND SURFACE.
(1966 DCSO) NOTE: PORTION
OF I.P. WITH BRASS CAP
NOT DUG OUT.

N/A

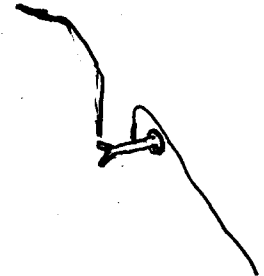

Accessories Found:

40" D. FIR NOW REMAINS OF ROOTS IN CAT ROAD CURBANK NEAR
REC (N82°W 23.8 FT) OBT
NE, SE AND SW OUT'S NOW GONE

5" NOW 11" DIA D. FIR WITH A FULLY HEALED DOUBLE BLAZE
BEARS, N 73°W, 39.7 FT (REC N 71 3/4°W 39.7 FT)
1960

12" NOW 22" DIA. 1 1/2 FT HIGH D. FIR STUMP WITH A
FULLY HEALED LOWER BLAZE, BEARS S 11°W, 15.0 FT
(AGREES WITH REC) 1960

10" NOW 21" DIA 4 FT HIGH D. FIR STUMP WITH A
FULLY HEALED DOUBLE BLAZE BEARS S 62 3/4°E, 43.3 FT
(AGREES WITH REC) 1960

1960 NE BT NOW GONE

C.S. File No. 65/9-5

RENEWAL

Monument Set (Procedure and Description)

POSITION OF FLANGES ON FOUND IRON PIPE CHECKS WELL WITH A POSITION DETERMINED FROM REMAINING BT'S. A 2 3/8" DIA. BRASS CAPONA 1 3/8" O.D. BY 32" LONG IRON PIPE IS PLUMB OVER FLANGES OF FOUND IRON PIPE. NEW BC/IP PROTRUERS 5" ABOVE GROUND.

Monument Detail

DOUGLAS COUNTY SURVEYORS OFFICE

T315

S19	S20	R
S30	S29	W


1996

New Accessories

4" MADRONE BARK SCRIBED "T315 RGW S30 CS BT"
BEARS S 46 1/2° W, 23.5 FT

6" D. FIR DOUBLE BLAZED AND SCRIBED "T315 RGW S19 CS BT"
BEARS N 49° W, 31.2 FT

Sketch of Monument, Accessories, and General Area

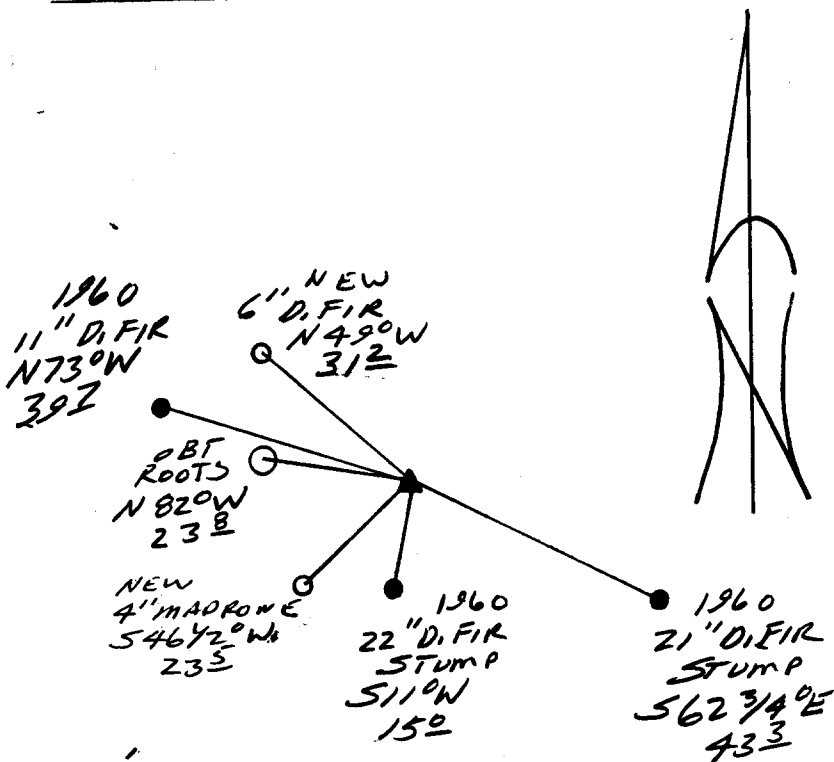

Location & Comments

Comp. Declin. 17 3/4° E
Agency DLCO
Party Chief RANDALL W. SMITH
Notekeeper *[Signature]*
Witnesses STEPHEN J. FINKE

Address

Surveyor's Seal

REGISTERED PROFESSIONAL LAND SURVEYOR

[Signature]
EXPIRES 7-30-98

OREGON
JULY 25, 1990
RANDALL W. SMITH
2469