

GOVERNMENT CORNER RESTORATION FORM

Date: 11-6-96 By: JP

This survey consists of:

Township 31S Range 7W Sec. 23 County DOUGLAS Map: \_\_\_\_\_

State OR Date 9/96 No. \_\_\_\_\_ Narrative: \_\_\_\_\_

Corner Rpt: C.S. 65/9-8

Corner Designation

S23 | S24  
---  
S26 | S25

DOUGLAS COUNTY SURVEYOR

- Condition Report Only
- Not Found
- Renewed
- Unrecorded
- Surveyed In
- Referenced Out

MONUMENT DETAIL

Previous Renewals 1963 JOHNSTONE PI# 600300

Monument(s) Found: (Condition and Source)

BENT 1" I.D. IRON PIPE  
PROTRUS 1 FT ABOVE GROUND.  
1/4 BENT IN A SOUTH WEST  
DIRECTION. (1963)

N/A

Accessories Found:

34" NW 24" DIA. 2 FT HIGH ROTTED D. FIR STUMP  
BARK IS OFF, NO SCRIBING FOUND, BEARS  
S40°E, 20.5 FT TO CENTER (REC. S40°E,  
19.1 FT, DIST WOULD FIT WELL TO BARK) 0BT

NO OTHER ORIG. BT'S FOUND

6" NW 6" DIA. 1 FT HIGH ROTTED D. FIR STUMP SCRIBING  
FOUND "BT" BEARS S78°E, 11.2 FT (AGRES WITH REC) 1963

34" NW 38" DIA 5 1/2 FT HIGH D. FIR STUMP  
WITH A FULLY HEALED DOUBLE BLAZE, BEARS  
S7 1/2°W, 43.0 FT (REC. S6°W 43.0 FT) 1963

1963 NW BT NOW GONE

12" NW 13" DIA 3 FT HIGH ROTTED CEDAR  
STUMP WITH SCRIBING VISIBLE "S24 BT" BEARS  
N63 1/2°E, 25.2 FT. (AGRES WITH REC) 1963

RENEWAL

Monument Detail

Monument Set (Procedure and Description)

2 3/8" DIA BRASS CAP ON A 1 3/8" O.D BY 32" LONG IRON PIPE IS SET AT PLUMP POSITION OF FOUND IRON PIPE, PROTRUDES 6" ABOVE GROUND

FOUND IRON PIPE IS 31" LONG IS SET ALONG NORTH EDGE OF BRICK PROTRUDES 10" ABOVE GROUND

DOUGLAS COUNTY SURVEYORS

T 31 S

523 524 R  
526 525 W

1996

OFFICE

575°E 495


New Accessories

5" DIA. D. FIR DOUBLE BLAZED AND SCRIBED "T31S R7W S25 CS BT" BEARS S75°E 14.9 FT

10" DIA. D. FIR DOUBLE BLAZED AND SCRIBED "T31S R7W S23 CS BT" BEARS N23 1/2°W, 49.5 FT

3" DIA. D. FIR DOUBLE BLAZED AND SCRIBED "X BT" BEARS N11°E, 3.0 FT

Sketch of Monument, Accessories, and General Area

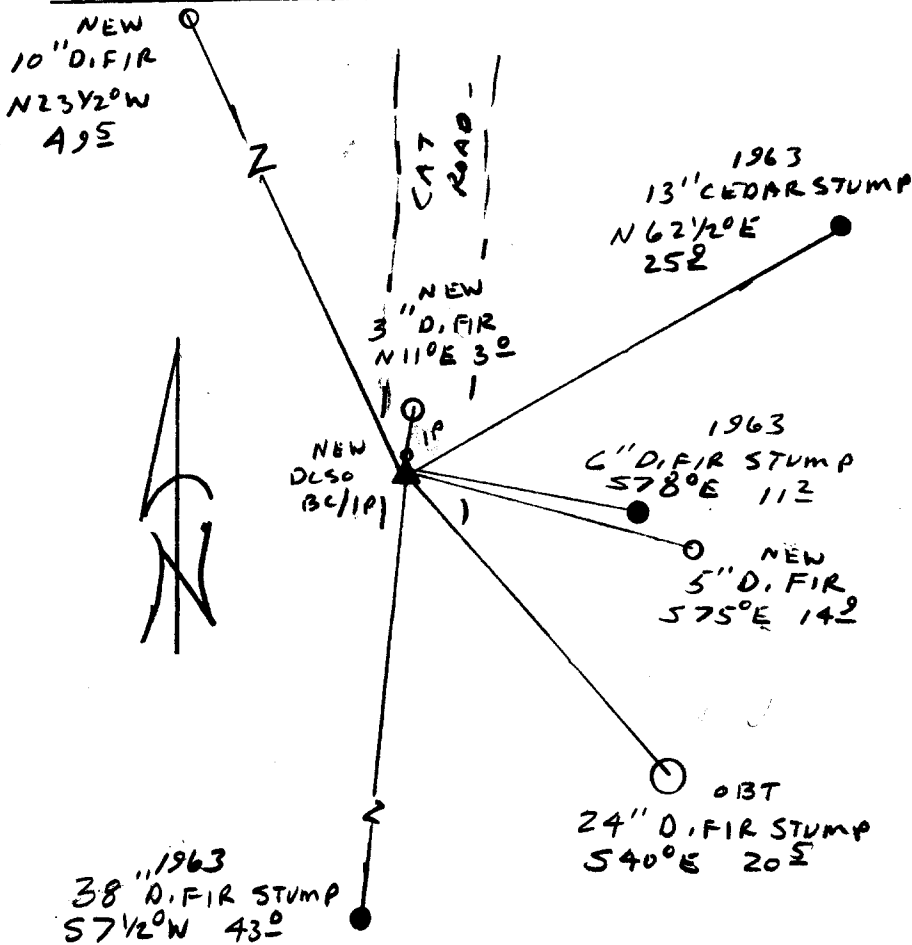

Location & Comments

Comp. Declin. 17 3/4° E  
Agency DCSO  
Party Chief RANDALL W SMITH  
Notekeeper Randall W Smith  
Witnesses STEPHEN J FLAUS

Address

REGISTERED PROFESSIONAL LAND SURVEYOR  
JULY 25, 1990  
RANDALL W. SMITH  
2468

Surveyor's Seal