

GOVERNMENT CORNER RESTORATION FORM

Date: 11-6-96 By: JP

This survey consists of:

Township 315 Range 7W Sec. 13 County DOUGLAS Map: _____

State OR Date 9-10-96 No. _____ Narrative: _____
Corner Rpt: C.S. 65/9-12

Corner Designation

$\frac{1}{4}$ $\frac{513}{524}$

DOUGLAS COUNTY SURVEYOR

- Condition Report Only
- Not Found
- Renewed
- Unrecorded
- Surveyed In
- Referenced Out

MONUMENT DETAIL

Previous Renewals 1966 DCSO PI# 640400

Monument(s) Found: (Condition and Source)

2 1/2" DIA. BRASS CAP ON A
1 1/2" O.D. IRON PIPE PROTRUDING
12" ABOVE GROUND. (1966)

COUNTY SURVEYORS OFFICE
T 315

3/4" I.D. IRON PIPE PROTRUDES
2" ABOVE GROUND. FOUND ALONG
NORTH EDGE OF BC/IP (SOURCE UNKNOWN)

$\frac{1}{4}$ $\frac{513}{524}$
1966

Accessories Found:

30" NOW 40" DIA. 4 FT HIGH CEDAR STUMP WITH A
PREVIOUSLY OPENED BLAZE SCRIBING VISIBLE "S"
BEARS N10°E, 23.8 FT (AGREES WITH 1966 DCSO REC.)
OBT

12" NOW 24" DIA. 4 FT HIGH D. FIR STUMP WITH A
PREVIOUSLY OPENED BLAZE, NO SCRIBING VISIBLE
BEARS S29°E, 18.5 FT (REC. S26°E 18.5 FT) OBT

26" NOW 26" DIA. 4 FT HIGH D. FIR STUMP WITH A
PARTIALLY HEALED DOUBLE BLAZE, SCRIBING VISIBLE "Y45"
BEARS S21°W 18.3 FT. (AGREES WITH REC.) 1966

RENEWAL

Monument Set (Procedure and Description)

Monument Detail


N/A

N/A

New Accessories

- 6" DIA. D. FIR DOUBLE BLAZED AND SCRIBED "1/4 S 24 CS RT" BEARS S64°E, 37.1 FT
- 5" DIA. D. FIR DOUBLE BLAZED AND SCRIBED "1/4 S 13 CS BT" BEARS N40°W, 26.9 FT
- 5" DIA. D. FIR DOUBLE BLAZED AND SCRIBED "1/4 S 13 CS RT" BEARS N69 1/2°W, 11.6 FT
- 3" DIA. CEDAR DOUBLE BLAZED AND SCRIBED "X RT" BEARS S56°W, 8.2 FT

Sketch of Monument, Accessories, and General Area

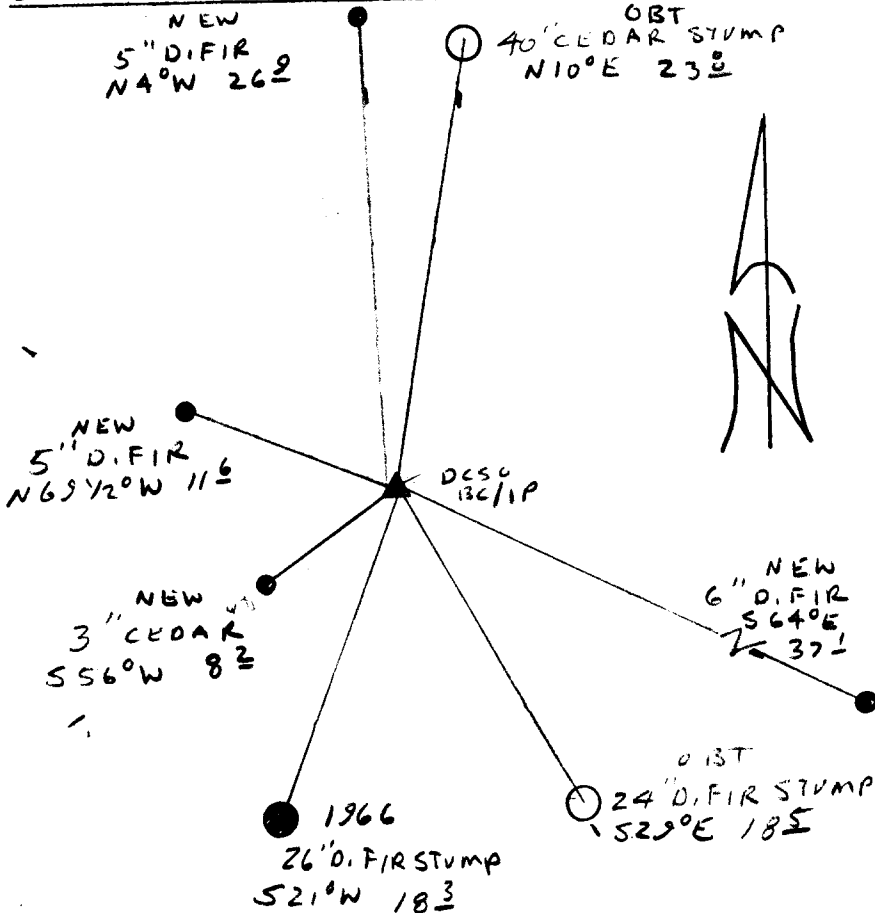

Location & Comments

Comp. Declin. 17 3/4° E
 Agency DLSO
 Party Chief RANDALL W. SMITH
 Notekeeper [Signature]
 Witnesses

Address

Surveyor's Seal

REGISTERED
 PROFESSIONAL
 LAND SURVEYOR

[Signature]

STARS 6-30-98

OREGON
 JULY 25, 1990
 RANDALL W. SMITH
 2469