

GOVERNMENT CORNER RESTORATION FORM

Date: 11-7-96 By: JP

This survey consists of:

Township 31S Range 7W Sec. 21 County DOUGLAS

Map: _____

State OK Date 9-12-96

Narrative: _____

No. _____ Corner Rpt: C.S. 65/9-13

Corner Designation

S 21 | S 22

S 28 | S 27

DOUGLAS COUNTY SURVEYOR

- ____ Condition Report Only
- ____ Not Found
- Renewed
- ____ Unrecorded
- ____ Surveyed In
- ____ Referenced Out

Previous Renewals 1964 BLM PI# 400300

MONUMENT DETAIL

Monument(s) Found: (Condition and Source)

3/4" DIA. BRASS CAP ON A 2 1/2" O.D. IRON PIPE PROTRUDES 6" ABOVE GROUND (1964 BLM)

U.S. CADASTRAL SURVEY
T 31S R 7W

S 21 | S 22

S 28 | S 27

1964

BUREAU OF LAND MANAGEMENT

Accessories Found:

9" NW 11" DIA. 1 FT HIGH D. FIR STUMP OPEN AND FIND SCRIBING "BT" BEARS N 59° E, 14.7 FT (REC N 59° E, 15.2 FT) 1964
15" NW 23" DIA D. FIR WITH A FULLY HEALED BLAZE BEARS N 81° W, 19.1 FT (AGREES WITH REC) 1964

15" NW 16" DIA 1 FT HIGH D. FIR STUMP WITH A FULLY HEALED LOWER BLAZE, BEARS S 18 1/2° W, 141.2 FT (AGREES WITH REC.) 1964 BLM

1964 SE BT NOT FOUND

RENEWAL

Monument Set (Procedure and Description)

Monument Detail

N/A

N/A

New Accessories

6" DIA D. FIR DOUBLE BLAZED AND SCRIBED "T315 R7W S28CS BT"
BEARS: S 31° W, 13.3 FT


5" DIA D. FIR DOUBLE BLAZED AND SCRIBED "T315 R7W S27CS BT"
BEARS, S 33° E, 9.7 FT

11" DIA PINE DOUBLE BLAZED AND SCRIBED "T315 R7W S 22 CS BT"
BEARS, N 0 1/2° E, 74.3 FT
Sketch of Monument, Accessories, and General Area

Location & Comments

Comp. Declin. 17 3/4° E
Agency DCSO
Party Chief RANDALL W. SMITH
Notekeeper [Signature]
Witnesses STEPHEN J. HAUSE

Address

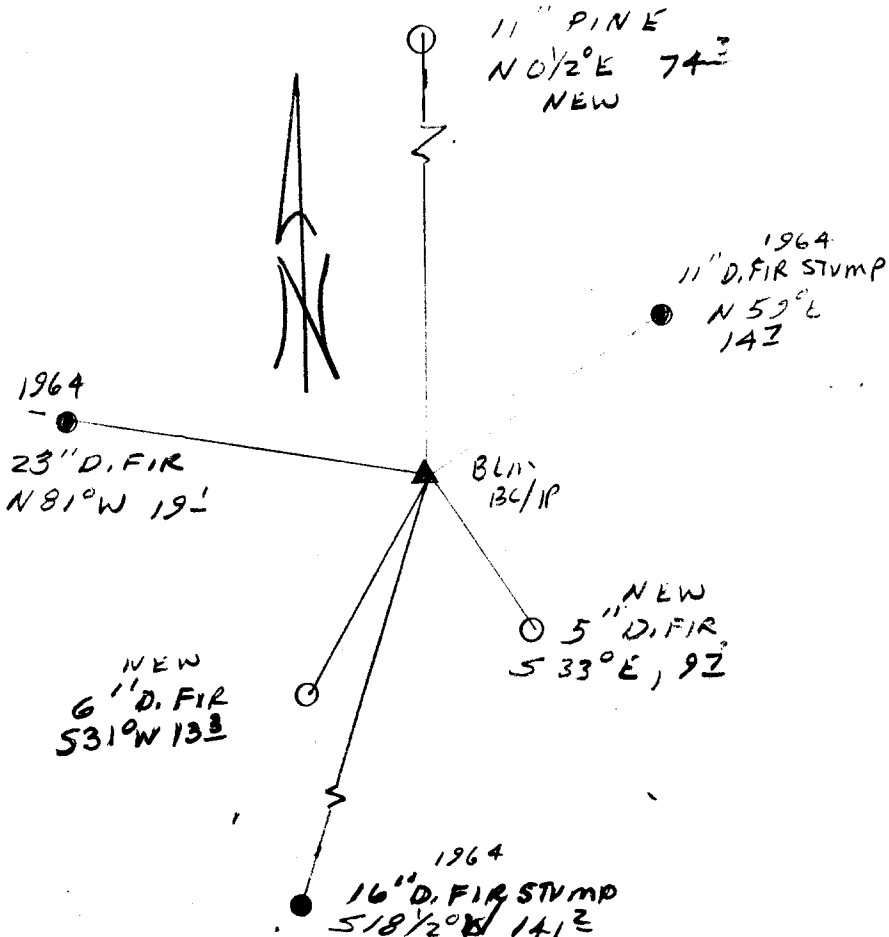

Surveyor's Seal
REGISTERED
PROFESSIONAL
LAND SURVEYOR

[Signature]
EXPIRES 6-30-98

OREGON
JULY 25, 1990
RANDALL W. SMITH
2469