

GOVERNMENT CORNER RESTORATION FORM

Date: 11-13-96 By: JP

This survey consists of:

Township 32S Range 7W Sec. 6 County DOUGLAS

Map: \_\_\_\_\_

State OR Date 9-25-96 No. \_\_\_\_\_

Narrative: \_\_\_\_\_

Corner Rpt: C.S. 65/9-18

Corner Designation

1/4 S 1 | 56

DOUGLAS COUNTY SURVEYOR

- Condition Report Only
- Not Found
- Renewed
- Unrecorded
- Surveyed In
- Referenced Out

MONUMENT DETAIL

Previous Renewals # 26 (1965 DCSO)

Monument(s) Found: (Condition and Source)

2 1/2" DIA. BRASS CAP ON A 1 1/2" O.D BY 36" LONG IRON PIPE IS FOUND OUT OF GROUND (1965)

COUNTY SURVEYORS OFFICE

Y 4  
R 8  
W  
T 3 2 S  
51 | 56  
R 7  
W  
1965

Accessories Found:

14" NW 24" DIA DOWN D. FIR WITH A FULLY HEALED SINGLE BLAZE NO BARK SCRIBING VISIBLE (A PORTION OF LOWER TRUNK IS COVERED UP) POSITION OF ROOTS AGREES WELL WITH RECORD " N 70° W, 6.6 FT " OBT

10" NW 20" DIA 8 FT HIGH D. FIR STUMP WITH A FULLY HEALED SINGLE BLAZE BEARS S 55° E, 6.6 FT (AGREES WITH RECORD) OBT

C.S. File No. 65/9-18

RENEWAL

Monument Set (Procedure and Description)

1265 DCSO BC/IP IS SET AT A POSITION DETERMINED FROM CRT'S. BRASS CAP STAMPING "RESET 1996" IS ADDED. BC/IP PROTRUDES 6" ABOVE GROUND. A 2 FT DIA MOUND OF STONE PLACED AROUND BASE.


Monument Detail

COUNTY SURVEYORS OFFICE  
T 32 S

1/4  
R S W 51 | 56 7  
RESET 1996  
1965

New Accessories

- 48" DIA. 5 FT HIGH D. FIR STUMP WITH AN 8" BOAT SPIKE SET INTO TOP THROUGH BTAG 1 FT EASTERLY OF CENTER. BOAT SPIKE IS STAMPED "B02", B.S. BEARS N 80° W, 12.0 FT
  - 24" DIA. 3 FT HIGH D. FIR STUMP WITH AN 8" BOAT SPIKE SET INTO TOP NEAR CENTER THROUGH A BTAG. BOAT SPIKE IS STAMPED "B01", B.S. BEARS N 55 1/2° E, 52.5 FT
  - 4 IN. T IS CHISELED AT TOP OF NORTHERLY FACE OF LARGE ROCK OUTCROP 3' ABOVE GROUND, T BEARS S 58° W, 18.8 FT
- Sketch of Monument, Accessories, and General Area

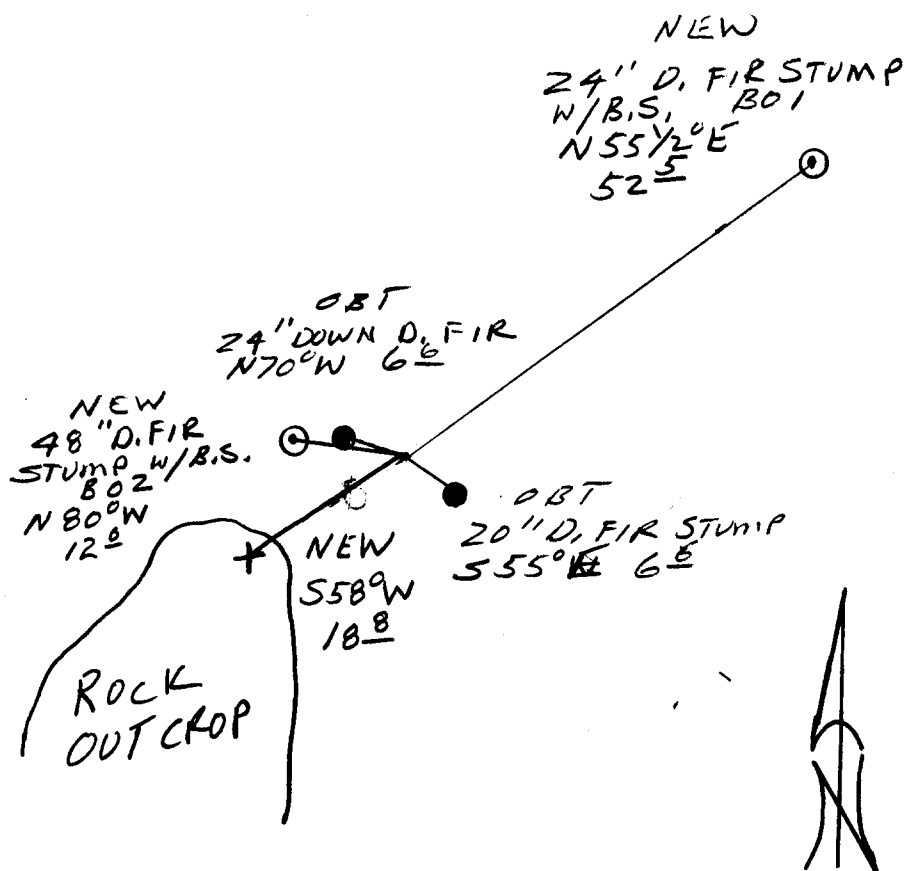

Location & Comments

CORNER LIES ON A STEEP NW'LY SLOPE. NO SCRIBIBLE TREES IN AREA AROUND CORNER.

CORNER LIES APPROX N 25° E 40 FT FROM TOP OF LARGE ROCK OUTCROP.

Comp. Declin. 17 3/4° E  
Agency DCSO  
Party Chief RANDALL W SMITH  
Notekeeper Randall W Smith  
Witnesses STEPHEN J FLAUSL

Address

Surveyor's Seal

REGISTERED PROFESSIONAL LAND SURVEYOR  
Randall W Smith  
EXPIRES 6-30-98  
OREGON  
JULY 25, 1990  
RANDALL W. SMITH  
2469