

GOVERNMENT CORNER RESTORATION FORM

Date: 11-15-96 By: JP

This survey consists of:

Township 24 S Range 1 W Sec. 27 County DOUGLAS


Map: _____

State OR Date 10-29-96 No. _____

Narrative: _____

Corner Rpt: C.S. 65/9-23

Corner Designation

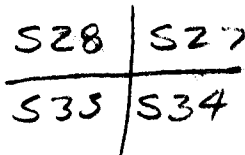

DOUGLAS COUNTY SURVEYOR

- Condition Report Only
- Not Found
- Renewed
- Unrecorded
- Surveyed In
- Referenced Out

MONUMENT DETAIL

Previous Renewals #13

Monument(s) Found: (Condition and Source)

2 1/2" DIA. BRASS CAP ON A 1 1/2" O.D. IRON PIPE PROTRUDS 11" ABOVE GROUND (#13) IS SURROUNDED BY A 1 FT MOUND OF STONE.

COUNTY SURVEYORS OFFICE

T 24 S R 1 W

S28 | S27

S33 | S34

1961

Accessories Found:

6" NOW 7" DIA. 5' HIGH ROTTED CHINQUAPIN SNAG WITH A ROTTED BLAZE, NO SCRIBING VISIBLE, BEARS S22°E, 5.3 FT (AGREES WITH REN#13 REC) ORT

10" NOW 22" DIA. 70' HIGH DEAD PINE SNAG WITH AN UNHEALED DOUBLE BLAZE, SCRIBING VISIBLE "T24S R1W S33 CS BT" BEARS S42°W, 17.8 FT (AGREES WITH REN#13 REC) ORT

NO OTHER ORIG BT'S FOUND

13" NOW 12" DIA. 4' HIGH ROTTED D. FIR STUMP WITH SCRIBING VISIBLE ON A PARTIALLY HEALED DOUBLE BLAZE "R1W" BEARS S47 1/2°E, 26.3 FT (AGREES WITH REC) REN#13

SW BT FROM REN#13 NOW GONE

RENEWAL

Monument Set (Procedure and Description)

Monument Detail


N/A

N/A

New Accessories

- 12" DIA D. FIR DOUBLE BLAZED AND SCRIBED "T245 RIWS28CS BT"
- BEARS N 84 1/2° W 21.7 FT
- 5" DIA HEMLOCK DOUBLE BLAZED AND SCRIBED "T245 RIWS33CS BT"
- BEARS S 33° W 6.4 FT
- 6" DIA. D. FIR DOUBLE BLAZED AND SCRIBED "T245 RIWS27CS BT"
- BEARS N 16° E 19.6 FT
- 3" DIA PISTOL BUTT HEMLOCK DOUBLE BLAZED AND SCRIBED "X BT" BRG AND DIST.
- TAKEN AT UPPER BLAZE ON STRAIGHT TRUNK, BEARS S 73° E 14.3 FT

Sketch of Monument, Accessories, and General Area

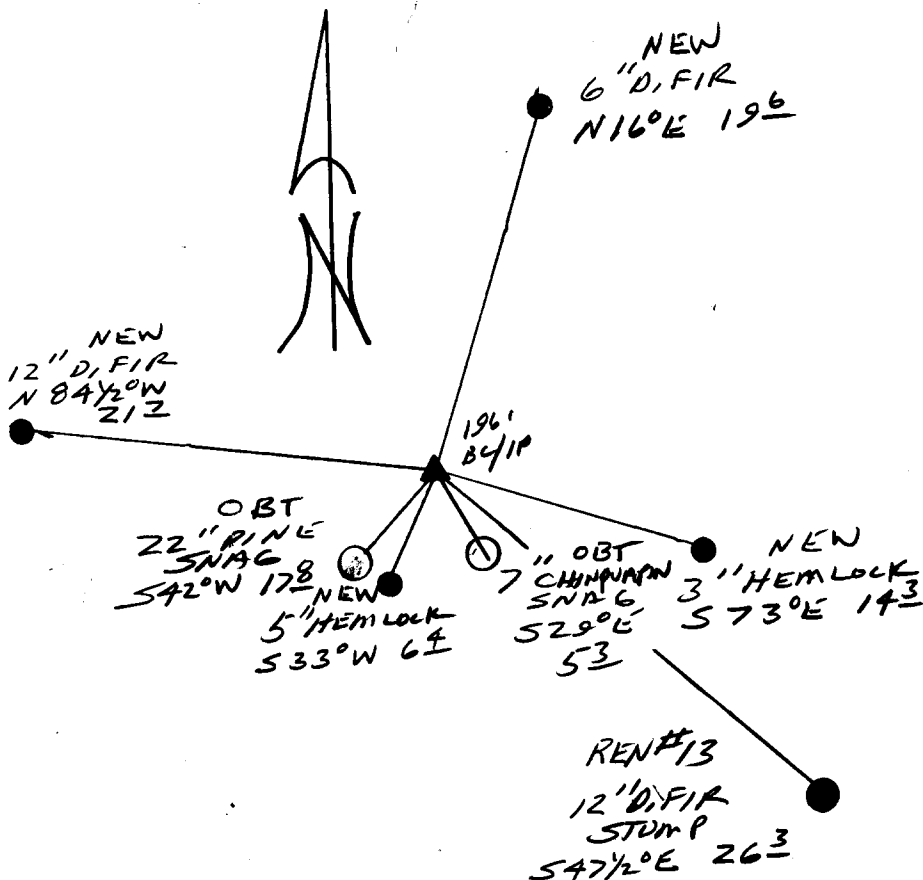

Location & Comments

Comp. Declin. 17 3/4° E
 Agency DCSG
 Party Chief RANDALL W SMITH
 Notekeeper Randall W. Smith
 Witnesses STEPHEN J FLAUSK

Address

Surveyor's Seal

REGISTERED
 PROFESSIONAL
 LAND SURVEYOR

Randall W. Smith
 JUN 26 6-30-98

OREGON
 JULY 25, 1990
 RANDALL W. SMITH
 2469