

GOVERNMENT CORNER RESTORATION FORM

Date: 11-19-96 By: JP

This survey consists of:

Township 29S Range 9W Sec. 22 County DOUGLAS

Map: _____

State OREGON Date 10/15/96 No. _____

Narrative: _____

Corner Rpt: C.S. 65/9-28

Corner Designation

1/4 522
+
527

DOUGLAS COUNTY SURVEYOR

- _____ Condition Report Only
- _____ Not Found
- ✓ Renewed
- _____ Unrecorded
- _____ Surveyed In
- _____ Referenced Out

Previous Renewals #54, #78

MONUMENT DETAIL

Monument(s) Found: (Condition and Source)

FROM RENEWAL #54 THE FOLLOWING MONUMENT: A 2 1/2 INCH DIAMETER BRASS CAP (MARKED AS AT RIGHT) ON A 1/2 INCH O.D. GALVANIZED IRON PIPE, FIRMLY SET AND PROTRUDING APPROXIMATELY 18 INCHES ABOVE GROUND.

A BURIED STONE ON THE NORTH EDGE OF THE BRASS CAP MONUMENT WITH THE MARKS "1/" VISIBLE, PROTRUDES APPROXIMATELY 4 INCHES ABOVE GROUND. RECORD FROM 1882 RETRACEMENT SURVEY CALLS FOR A 12 X 10 X 6 BASALT STONE; THE FOUND STONE IS SANDSTONE BUT THE SIZE IS REASONABLE AND THE MARKINGS APPEAR TO BE TIME WORN.

COUNTY SURVEYORS OFFICE

T29S R9W

1/4 522
+
527

1959

Accessories Found:

REMAINS OF TWO ORIGINAL B.T.S. A FIR, 12 INS. DIAM. NOW A 28 INCH DIAMETER 3 FOOT TALL ROTTED FIR STUMP WITH NO ORIGINAL MARKINGS FOUND BEARS S44°E, 9 3/4 FEET DISTANT (RECORD S44°E 8 1/2 FEET A FACE MEASUREMENT).

A FIR, 12 INS. DIAM. NOW A 24 INCH DIAMETER 3 FOOT TALL ROTTED FIR STUMP WITH REMAINS OF A HEALED BLAZE NOW OPENED TO REVEAL PARTIAL ILLEGIBLE SCRIBING BEARS N22°W, 9 3/4 FEET DISTANT (RECORD N22°W, 9° FT.; IN RENEWAL 54 RECORD N.22°W. 9.0 FT.)

THE BEARING TREE MARKED IN RENEWAL 54, A 16" R. FIR NOW A 24 INCH DIAMETER LOW CUT FIR STUMP WITH POSSIBLE REMAINS OF LOWER BLAZE EDGE, BEARS N23 3/4°W, 44 1/2 FEET DISTANT (RENEWAL 54 RECORD N22°W, 41 1/2 FT.)

THE BEARING TREE MARKED IN RENEWAL 78, A 17" FIR NOW 19 INCH D.B.H. DOUGLAS FIR WITH A FULLY HEALED DOUBLE BLAZE S10°W, 33 1/2 FEET DISTANT (AS PER RECORD).

RENEWAL

Monument Set (Procedure and Description)

NONE


Monument Detail

(NA)

New Accessories

A 10 INCH D.B.H DOUGLAS FIR, SCRIBED 1/4 S22 CS BT ON A DOUBLE BLAZE, BEARS N36°E, 13' FEET DISTANT.
A 17 INCH D.B.H DOUGLAS FIR SCRIBED 1/4 S27 CS BT ON A DOUBLE BLAZE, BEARS S49°E, 72' FEET DISTANT.
A 9 INCH D.B.H MADRONE SCRIBED 1/4 S22 CS BT ON A DOUBLE BLAZE, BEARS N25°W, 41' FEET DISTANT.

Sketch of Monument, Accessories, and General Area

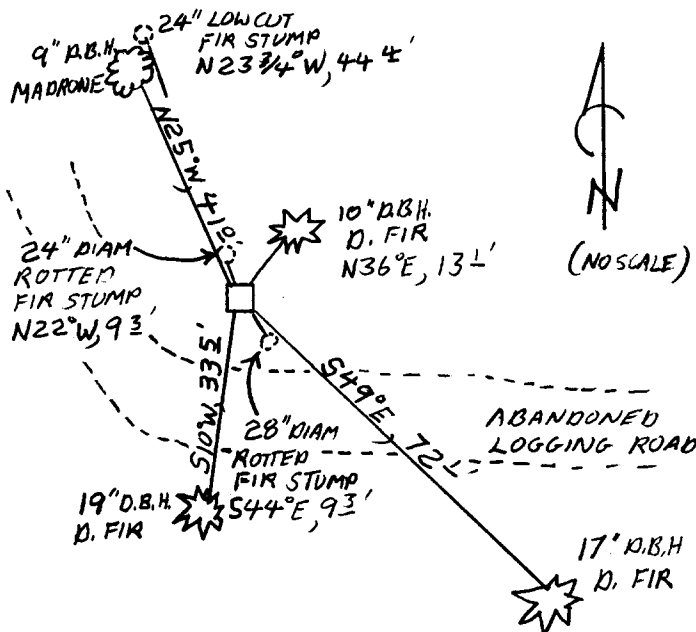

Location & Comments

MONUMENT LIES APPROXIMATELY 25 FEET NORTH OF ABANDONED LOGGING RD. RUNNING EASTERLY-WESTERLY.

Comp. Declin. 17 3/4° E
Agency KCSO
Party Chief STEPHEN JOHN FLAUXE
Notekeeper Stephen John Flauxe
Witnesses JOHN PIKE

Address

Surveyor's Seal

REGISTERED PROFESSIONAL LAND SURVEYOR
Randall W. Smith
EXPIRES 6-30-98
OREGON JULY 25, 1990 RANDALL W. SMITH 2469