

GOVERNMENT CORNER RESTORATION FORM

Date: 11-19-96 By: JP

This survey consists of:

Township 29S Range 9W Sec. 15

County DOUGLAS Map: _____

State OR Date 10-23-96

No. _____ Narrative: _____

Corner Rpt: C.S. 65/9-30

Corner Designation

DOUGLAS COUNTY SURVEYOR

$\frac{1}{4} \frac{S15}{S22}$

- Condition Report Only
- Not Found
- Renewed
- Unrecorded
- Surveyed In
- Referenced Out

Previous Renewals #50

MONUMENT DETAIL

Monument(s) Found: (Condition and Source)

2 1/2" DIA BRASS CAP ON A 1 1/2"
O.D. IRON PIPE CONCRETE INTO
A SAND STONE LEDGE BC/IP
PROTRUS 8 IN. (#50)

COUNTY SURVEYORS OFFICE
T29S R9W

$\frac{1}{4} \frac{S15}{S22}$

1959

Accessories Found:

ORIG MAPLE NOW GONE

50" NOW 56" DIA 12 FT HIGH BURNT D. FIR SNAG
SHOWS EVIDENCE OF BEING OPENED NO SCRIBING
VISIBLE BEARS S80°E, 17.2 FT (BET
CAGREES WITH REC.)

18" NOW 27" DIA CEDAR WITH A FULLY HEALED DOUBLE
BLAZE, BEARS S55 1/2°E, 42.7 FT (CAGREES WITH REC.)
REN #50

RENEWAL

Monument Set (Procedure and Description)

Monument Detail

N/A

N/A


New Accessories

6" DIA. D. FIR DOUBLE BLAZED AND SCRIBED "1/4 522 CS BT"
BEARS S 30 1/2° E, 36.6 FT

1 1/2" DIA MAPLE DOUBLE BLAZED AND SCRIBED "1/4 515 CS BT"
BEARS N 73 1/2° W, 25.4 FT

6" DIA MADRONE BARK SCRIBED "1/4 515 CS BT" BEARS N 69° E, 31.9 FT

Sketch of Monument, Accessories, and General Area

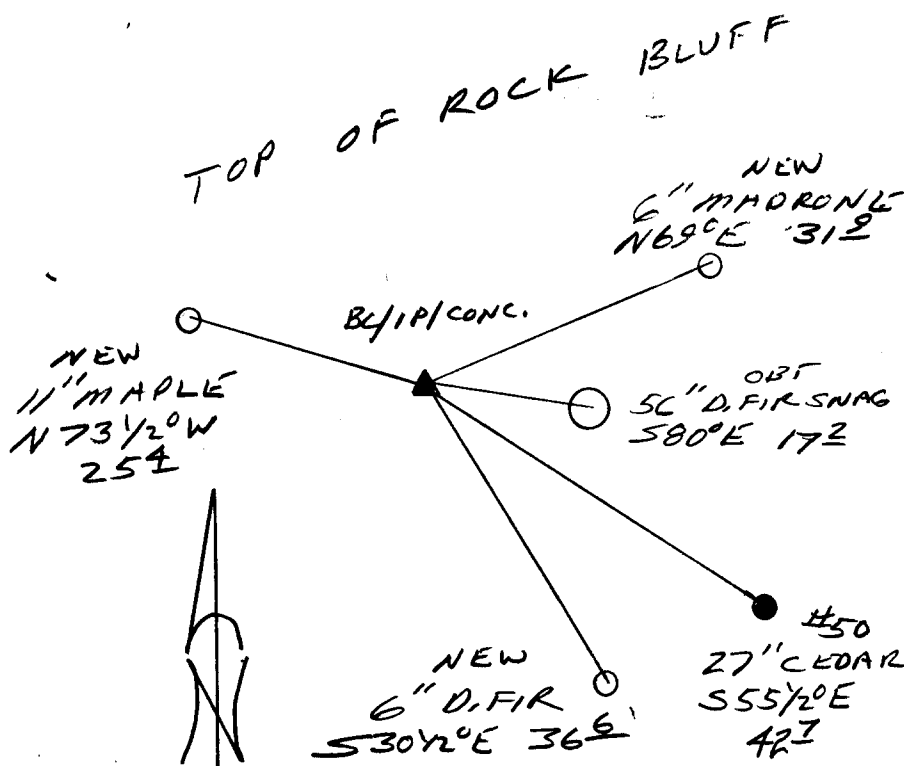

Location & Comments

CORNER LIES ON A
STEEP SOUTHERLY FACING
ROCK BLUFF

Comp. Declin. 17 3/4° E
Agency DLSD
Party Chief RANDALL W. SMITH
Notekeeper [Signature]
Witnesses STEPHEN J. HAUSE

Address

Surveyor's Seal

REGISTERED
PROFESSIONAL
LAND SURVEYOR

Randall W. Smith
EXPIRES 6-30-98

OREGON
JULY 25, 1990
RANDALL W. SMITH
2489