

GOVERNMENT CORNER RESTORATION FORM

Date: 12-17-96 By: JP

Township 25S Range 2E Sec. 28

County DOUGLAS This survey consists of:

State OR Date 11-6-96

Map: _____

Narrative: _____

Corner Rpt: CS 65/9-33

Corner Designation

1/4 S29/S28

DOUGLAS COUNTY

Condition of Report Only

Not Found

Renewed

Unrecorded

Surveyed In

Referenced Out

MONUMENT DETAIL

Previous Renewals N/A

Monument(s) Found: (Condition and Source)

2 1/2" DIA. BRASS CAP ON 1" O.D. IRON PIPE, PROTRUDES 1" ABOVE GROUND (ORIG. CORNER)

U.S. GENERAL LAND

1/4 S29/S28

1928

OFFICE SURVEY

Accessories Found:

20" NOW 24" DIA. D. FIR WITH A FULLY HEALED SINGLE BLAZE, BEARS N65°E, 40.9 FT (AGREES WITH REC) OBT

8" NOW 9" DIA D. FIR WITH A FULLY HEALED SINGLE BLAZE, BEARS N85°W, 42.2 FT TO CENTER OF TRUNK 42.9 TO CENTER OF ROOT CROWN (REC N85°W 42.2 FT) OBT

RENEWAL

Monument Set (Procedure and Description)

Monument Detail

N/A

N/A


New Accessories

11" DIA. FIR DOUBLE BLAZED AND SCRIBED " 1/4 S 29 CS BT "
BEARS S 33° W 16.0 FT

21" DIA. MAPLE DOUBLE BLAZED AND SCRIBED " 1/4 S 28 CS BT
BEAR N 79° E, 35.0 FT

Sketch of Monument, Accessories, and General Area

Location & Comments

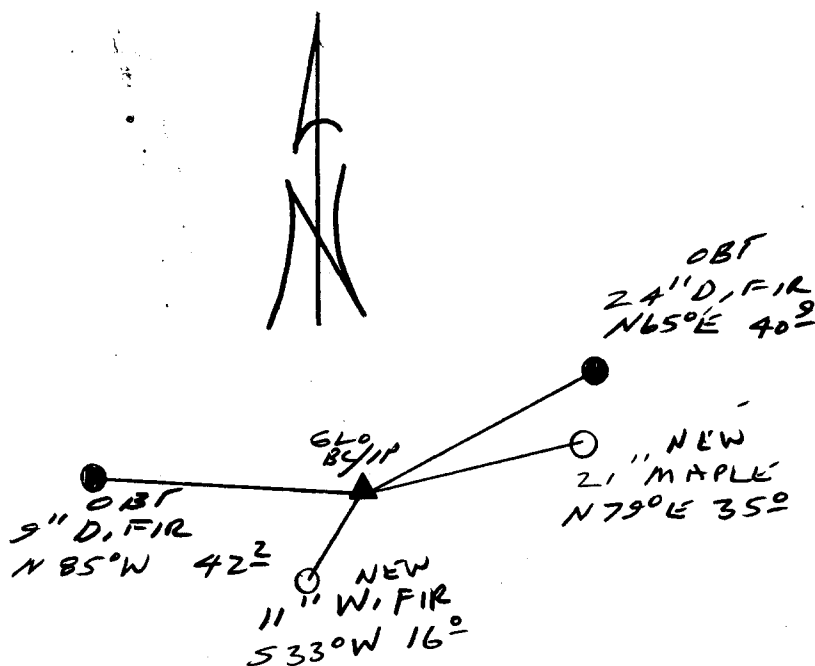

Comp. Declin. 17 3/4° E
 Agency DCSO
 Party Chief RANDALL W SMITH
 Notekeeper Backed W Smith
 Witnesses STEPHEN J FLAUSE

Address

Surveyor's Seal

REGISTERED/
 PROFESSIONAL
 LAND SURVEYOR

Randall W Smith
 EXPIRES 6-30-98

OREGON
 JULY 25, 1990
 RANDALL W. SMITH
 2469