

GOVERNMENT CORNER RESTORATION FORM

Date: 12-17-96 By: JP

This survey consists of:

Township 25S Range 2E Sec. 20 County DOUGLAS Map: _____

State OR Date 11-21-96 No. _____

Narrative: _____

Corner Rpt: C.S. 65/9-34

Corner Designation

S 20 | S 21

S 29 | S 28

DOUGLAS COUNTY SURVEYOR

- ____ Condition Report Only
- ____ Not Found
- Renewed
- ____ Unrecorded
- ____ Surveyed In
- ____ Referenced Out

MONUMENT DETAIL

Previous Renewals N/A

Monument(s) Found: (Condition and Source)

2 1/2" DIA BRASS CAP ON A 2" O.D IRON PIPE PROTRUDES 30" ABOVE GROUND. A 2' DIA MOUND OF STONE IS AROUND BASE (ORIG COR)

U.S. GENERAL LAND OFFICE SURVEY

T 25S R 2E

S 20 | S 21

S 29 | S 28

1928

Accessories Found:

ORIG. BT'S

12" NOW 12" DIA 6 FT HIGH CEDAR STUMP WITH AN UNHEALED SINGLE BLAZE SCRIBING VISIBLE " 25S 2E S 21 BT " BEARS N 67° E, 8.5 FT (REC N 67° E 7.9 FT DIST TO BLAZE)

16" NOW 20" DIA 5 FT HIGH HEMLOCK STUMP WITH A UNHEALED SINGLE BLAZE SCRIBING VISIBLE " 25 2 E S 28 BT " BEARS S 41 1/2° E 10.7 FT (REC S 39° E 9.9 FT DIST TO BLAZE)

16" NOW 20" DIA 5 FT HIGH HEMLOCK STUMP WITH A UNHEALED SINGLE BLAZE SCRIBING VISIBLE " 25 2 E S 28 BT " BEARS S 45° W, 15.1 FT (REC S 45° W 14.5 FT DIST TO BLAZE)

9" NOW 9" DIA DOWN A ROTTED HEMLOCK WITH A ROTTED UNHEALED SINGLE BLAZE BEARS N 31° W 17.8 FT TO ROOT CHOLEN (AGREES WITH REC)

*14
X
0

RENEWAL

Monument Set (Procedure and Description)

WILL SET MONUMENT
LOWER AT A FUTURE DATE


Monument Detail

N/A

New Accessories

5" DIA. D.FIR DOUBLE BLAZED AND SCRIBED "T25SRZE S21CSBT"
BEARS N82°E, 28.2 FT
5" DIA. D.FIR DOUBLE BLAZED AND SCRIBED "T25SRZE S21CSBT"
BEARS N43 1/2°E 23.8 FT
3" DIA CEDAR DOUBLE BLAZED AND SCRIBED "VBT" BEARS S11°E 11.2 FT
5" DIA D.FIR DOUBLE BLAZED AND SCRIBED "T25SRZE S21CSBT"
BEARS N75°W, 6.0 FT

Sketch of Monument, Accessories, and General Area

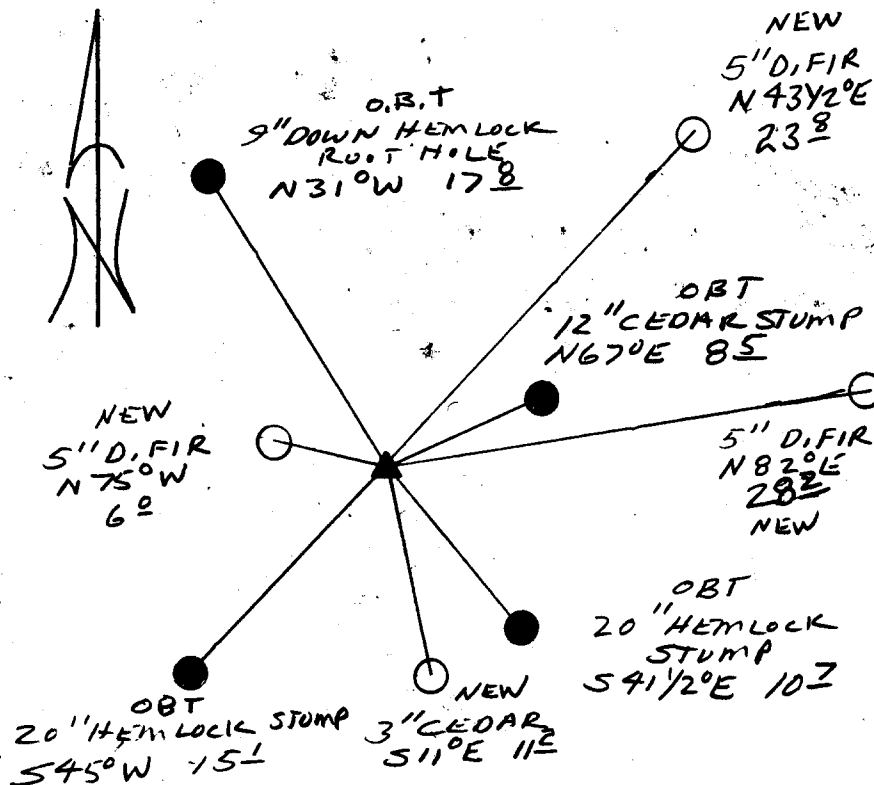

Location & Comments

Comp. Declin. 17 3/4° E
Agency DCSO
Party Chief RANDALL W. SMITH
Notekeeper
Witnesses STEPHEN J. PLUSE

Address

Surveyor's Seal

REGISTERED
PROFESSIONAL
LAND SURVEYOR

Randall W. Smith
EXPIRE 6-30-98

OREGON
JULY 25, 1990
RANDALL W. SMITH
2469