

FILED

Date: 7/25/97 By: BS

This survey consists of:

Map: M 127-26

Narrative:

Corner Rpt: CS 65/15-8A-8

OREGON CORNER RESTORATION FORM

Section 22 Township 225 Range 4W

County Douglas Date July 23, '97

DOUGLAS COUNTY  
SURVEYOR

Corner Designation

522 | 523  
527 | 526

- Condition Report Only
- Not Found
- Renewed
- Unrecorded
- Surveyed In
- Referenced Out

Previous Renewals/Surveys, etc.

The Douglas County Surveyor's Office set Brass Caps, etc. here in 1982. The corner & BT's are still basically the same except that the 60" Fir BT & the 48" Cedar BT have miraculously become stumps.

BS Shaner

Monument Detail

Sketch

Monument Set (Procedures and Description)

\_\_\_\_\_  
\_\_\_\_\_  
\_\_\_\_\_

New Accessories

None

Location & Comments

About 80 feet West of a dirt logging road.

Compass Declination 20°E

Firm/Agency Shaner Engineering, Inc.

Address P.O. Box 1430

Roseburg, Oregon 97470

Party Chief B. Shaner

Notes

Witness C. Berlier

D. Snyder

Surveyor's Seal

REGISTERED  
PROFESSIONAL  
LAND SURVEYOR

Bruce A. Shaner

OREGON  
OCT. 4, 1967  
BRUCE A. SHANER  
430

Renewal June 20, '98

C.S. File No. 65/15-8A

FILED

Date: 7-25-97 By: BC

This survey consists of:

Map: M 127-26

Narrative: \_\_\_\_\_

Corner Rpt: CS 65/15-8B

OREGON CORNER RESTORATION FORM

Section 22 Township 22S Range 4W

County Douglas Date July 23, '97

DOUGLAS COUNTY SURVEYOR

Corner Designation

1/4 522  
527

- Condition Report Only
- Not Found
- Renewed
- Unrecorded
- Surveyed In
- Referenced Out

Previous Renewals/Surveys, etc.

The Douglas County Surveyor's Office set Brass Cap, etc. in 1982 & the corner & BT's are still basically the same.

Monument(s) & Accessories Found: (Condition and Source)

N/A

Monument Detail

Sketch

N/A

Monument Set (Procedures and Description)

None

New Accessories

None

Location & Comments

Corner is about 300 feet S45°E from old Sehlin Barn.

Compass Declination 20°E

Firm/Agency Shaner Engineering, Inc.

Address P.O. Box 1430 Roseburg, Oregon 97470

Party Chief B. Shaner

Notes \_\_\_\_\_

Witness C. Barber  
D. Snyder

Surveyor's Seal

REGISTERED PROFESSIONAL LAND SURVEYOR

Bruce A. Shaner

OREGON OCT. 4, 1957 BRUCE A. SHANER 430

Renews June 30, 1998

C.S. File No. 65/15-8B

FILED

Date: 7/25/97 By: BC

This survey consists of:

Map: M 127-26

Narrative:

Corner Rpt: CS 65/15-80

OREGON CORNER RESTORATION FORM

Section 22 Township 22S Range 4W

County Douglas Date July 23, 1997

DOUGLAS COUNTY SURVEYOR

Corner Designation

521 | 522  
528 | 527


- Condition Report Only
- Not Found
- Renewed
- Unrecorded
- Surveyed In
- Referenced Out

Previous Renewals/Surveys, etc. Corner was set by Wilford Haines from witness by Ed Sehn, who had lived there since 1900<sup>±</sup>. (1957 Survey by Haines). Corner fits with Monument(s) & Accessories Found: (Condition and Source) Coles' Survey of 1915, I found Haines T Iron on South bank of small stream from which a:

- Cedar End Post (of fence that runs North) bears North, 190 feet.
- 36" D. Fir BT (record 26"), bark scribes visible, bears N88 1/2° E (record S88° E), 95.5 feet. (Record 105.8 feet was probably slope dist.).
- 72" D. Fir BT (record 52"), bark scribes visible, bears N31° W, 53.4 feet (Record 62.2 FT was probably slope distance).
- Old Taps & Haines' Brass Washers on both Trees.

Monument Detail

Sketch

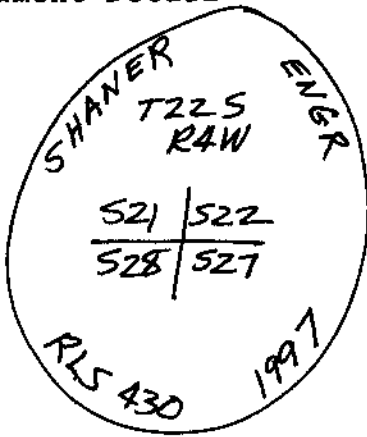

Monument Set (Procedures and Description)

I set a 3 1/4" Aluminum Cap on a 2 1/2" x 30" Alum. Pipe, Cap marked as above, from which a:

New Accessories

- 1 1/2" D. Fir BT, I scribed "T22S, R4W, S27, BT" bears S14° E, 16.2 feet.
- 8" D. Fir BT, I scribed "T22S, R4W, S28, BT," bears S87° W, 26.6 feet.
- I reset Haines T Iron alongside Alum. Pipe.

Location & Comments

Surveyor's Seal

Corner is in Creek Bottom at 100 feet West of Recked Road to Sehn Home. Compass Declination 20° E  
 Firm/Agency Shaner Engineering, Inc.  
 Address P.O. Box 1430 Roseburg, OR 97470  
 Party Chief B. Shaner  
 Notes "  
 Witness C. Beckler D. Snyder

REGISTERED PROFESSIONAL LAND SURVEYOR

Pruce A. Shaner  
 OREGON OCT. 4, 1957 PRUCE A. SHANER 430

Renewed June 30, 1998  
 C.S. File No. 65/15-80

FILED

Date: 7/25/97 By: BC

This survey consists of:

Map: M127-26

Narrative: \_\_\_\_\_

Corner Rpt: CS 65/15-80

OREGON CORNER RESTORATION FORM

Section 23 Township 22S Range 4W

County Douglas Date July 23, 1997

DOUGLAS COUNTY SURVEYOR

Corner Designation

W 1/4 523  
526

- Condition Report Only
- Not Found
- Renewed
- Unrecorded
- Surveyed In
- Referenced Out

Previous Renewals/Surveys, etc.

Corner was surveyed in by Herb Jones in 1958,  
County Survey Map File No. M12-42.

Monument(s) & Accessories Found: (Condition and Source)

Found 3/4" Iron Pipe, from which a  
28" D. Fir BT, face overgrown, (meas 20"), bears  
N12°E, 22.3 feet.

18" D. Fir BT, (Record 10"), face overgrown, bears  
S31°W, 36.4 feet.

Monument Detail

Sketch

None

Monument Set (Procedures and Description)

None.

New Accessories

None.

Location & Comments

ON E-W  
Timber Cutting  
Line.  
Well Tagged.

Compass Declination 20°E  
Firm/Agency Shaner  
Engineering, Inc.  
Address P.O. Box 1430  
Roseburg, OR 97470  
Party Chief B. Shaner  
Notes \_\_\_\_\_  
Witness D. Snyder

REGISTERED  
PROFESSIONAL  
LAND SURVEYOR

Bruce A Shaner

OREGON  
OCT. 4, 1957  
BRUCE A. SHANER  
430

Renews June 30, '98

C.S. File No. 65/15-80