

FILED

Date: 9-17-97 By: JP

This survey consists of:

Map: _____

Narrative: _____

Corner Rpt: CS 65/15-12

OREGON CORNER RESTORATION FORM

Section 18 Township 21S Range 4W

County Douglas Date July 14, '97

DOUGLAS COUNTY SURVEYOR

Corner Designation

R5W	R4W
513	518
524	519

T21S

Condition Report Only

Not Found

Renewed

Unrecorded

Surveyed In

Referenced Out

Previous Renewals/Surveys, etc.

Douglas County Survey Office, 1968

Charles W. Guile, 1986 (M 103-9)

Monument(s) & Accessories Found: (Condition and Source)

Found Douglas Co. Survey Office Brass Cap on 1" I. Pipe from which

15" D. Fir BT, face old, bears N16 1/2° E, 342 feet.


32" D. Fir BT, " " , bears S45° E, 341 feet.

32" D. Fir BT, " " , bears S30 1/2° E, 375 feet.

10" D. Fir BT, freshly scribed (USBLM?), bears S9 1/2° W, 15 1/2 feet.

Monument Detail

Sketch

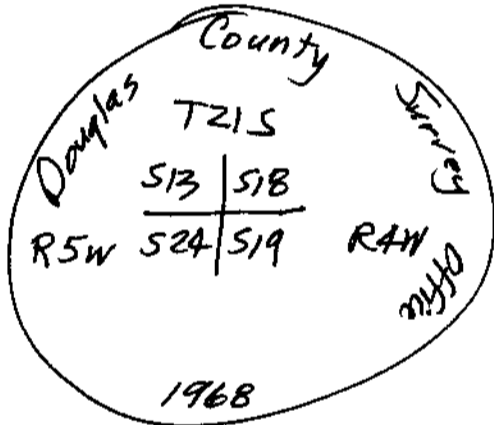

Monument Set (Procedures and Description)

N/A

New Accessories

12" D. Fir BT, I scribed "T21S, R5W, 513, BT" bears
N31° W, 11 1/2 feet

Location & Comments

Corner is on
East-West
Fence Line.

Compass Declination 20° E

Firm/Agency Shaner

Engineering, Inc.

Address P.O. Box 1430

Roseburg, OR 97470

Party Chief B. Shaner

Notes " "

Witness C. Berlier

Surveyor's Seal

REGISTERED PROFESSIONAL LAND SURVEYOR

Bruce A. Shaner
OREGON
OCT. 4, 1957
BRUCE A. SHANER
430

Renewed June 30, 98

C.S. File No. 65/15-12