

FILED

Date: 10-20-97 By: PC

This survey consists of:

Map: \_\_\_\_\_

Narrative: \_\_\_\_\_

Corner Rpt: CS 65/15-16

OREGON CORNER RESTORATION FORM

Section 19 Township 22S Range 8W

County DOUGLAS Date 10-7-97

DOUGLAS COUNTY  
SURVEYOR

Corner Designation

19	20
30	29

- Condition Report Only
- Not Found
- Renewed
- Unrecorded
- Surveyed In
- Referenced Out

Previous Renewals/Surveys, etc. 200300

Monument(s) & Accessories Found: (Condition and Source)

1965 CADASTRAL I.P.B.C.

12" FIR STUMP N38E 15<sup>2</sup>

8" FIR STUMP S34E 9<sup>2</sup> Visible Scribe

8" FIR STUMP S86W 17<sup>3</sup>

Monument Detail

Sketch

Monument Set (Procedures and Description)

New Accessories

SET 2 - 2" x 48" I.R. WITH TAGS NORTH 10° West 10°

6' steel fence post set near corner

Location & Comments

SEC COR FALLS IN A

CLEAR CUT - NO TREES

AVAILABLE - PUT TAGS

ON REMAINING BT

STUMPS

Compass Declination 19°

Firm/Agency ROSEBURG

FOREST PRODUCTS

Address PO Box 1088


ROSEBURG ORE 97470

Party Chief Bill Olson

Notes \_\_\_\_\_

Witness FLOYD WHITE

Surveyor's Seal

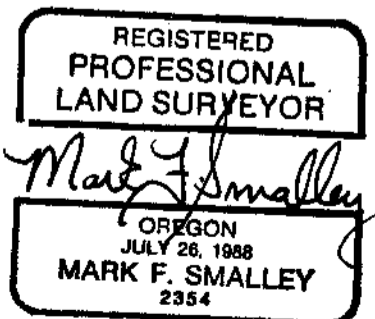

RENEWS 6/30/98

C.S. File No. 65/15-16